

SURVEY &  
REMONUMENTATION

APR 05 1996

OTTAWA COUNTY REMONUMENTATION

COMMISSION

LAND CORNER RECORDATION CERTIFICATE  
Filing Requirement of Act 74, Mich. P.A. 1970

For corners in  
OTTAWA  
(County)

	Located In:	Corner Code #/
1. Public Land Survey	T6N R13W	E-4 (E 1/4 cor Section 8) Georgetown Twp.
	T ___ R ___	_____
	T ___ R ___	_____
	T ___ R ___	_____
2. Property Controlling in Section	S ___ T ___ R ___	_____
	S ___ T ___ R ___	_____
3. Miscellaneous Property in Sec.	S ___ T ___ R ___	_____
	S ___ T ___ R ___	_____

RECORDED

95 NOV 15 PM 2:12

*Dorothy C. Redman*  
REGISTER OF DEEDS  
OTTAWA COUNTY, MI

Register of Deeds Stamp & File Number

4. Lot No. \_\_\_\_\_, Recorded Plat \_\_\_\_\_  
5. Private Claims \_\_\_\_\_

I, Randal J. Vugteveen, in a field survey on October 10, 19 95, do hereby certify that under requirements of P.A. 74, Michigan P.A. of 1970, the corner points mentioned in lines 1 and 2 above were in conformance with regulations and rules therefore as required in the current manual of survey instructions of the United States Department of the Interior, Bureau of Land Management or by a decree of a Court of Law and/or that the corner points mentioned in lines 3, 4 and 5 above were in conformance with the rules of the Michigan Board of Land Surveyors or by a Decree of a Court of Law; established, re-established, monumented, re-monumented, recovered, found as expressed below:

**NOTE: Not more than 4 corners, all in the same town and range, may be recorded on this certificate.**

	A	B	C	D	E	F	G	H	I	J	K	L	M
2	6	5	4	3	2	1							
3													
4	7	8	9	10	11	12							
5													
6	10	17	16	15	14	13							
7													
8	19	20	21	22	23	24							
9													
10	30	29	28	27	26	25							
11													
12	31	32	33	34	35	36							
13													

A. Description of original monument and accessories and/or subsequent restoration:

E-4 Common corner to Sections 8 & 9

1831 - Sibley	Liber 1, Page 189
Set HMP	1" iron found in centerline road on tree lines
Sugar S5 W28 24 Links	NE cor hse fnd S19W 88.15'
Beech N53 E24 24 Links	NW cor hse fnd S42W 112.52'
	CP pole N62W 126.15'
	30" Maple S4W 27.67'

B. Description of corner evidence found and/or method applied in restoring or reestablishing corner:

E-4 Found CIM without top on centerline Bauer Road & treeline N&S and accepted as a careful and faithful perpetuation of the position of the original corner

NE corner hse fndn S19 deg W 88.17'  
NW corner hse fndn Az 221 deg 112.35'

P.A. 345 OTTAWA COUNTY


PEER APPROVED 10/23/95

*Madry D. Medewald*  
S O 7

C. Description of monument for corner and accessories established to perpetuate locating the position of the corner:

E-4 Cast Iron Monument in mon box

Set Ottawa County Remon Nail & Tag on E side 8" Twin Maple AZ. 26 deg 44.26'  
Set Ottawa County Remon Nail & Tag on S side p. pole Az. 297 deg 123.91'  
NE corner brick hse #3225 Bauer Rd. AZ. 197 deg 88.17'  
NW corner concrete foundation garage #3225 Az. 227 deg 134.30'

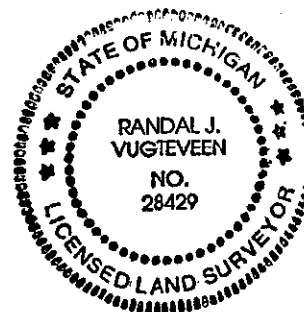

Signed by

*Randal J. Vugteveen*

Date

Oct. 20, 1995

Surveyor's Michigan License No.

28429

FORM APPROVED BY MICHIGAN STATE BOARD OF LAND SURVEYORS, JAN. 28, 19  
REVISED MAY 14, 19  
REVISED JAN., 19