OTTAWA COUNTY REMONUMENTATION

RECORDED

93 DEC 15 AM 9:26

REGISTER OF DEEDS
OTTAWA COUNTY, MI

LAND CORNER RECORDATION CERTIFICATE
Filing Requirement of Act 74, Mich. P.A. 1970

For corners in OTTAWA (County)

	Located In:	Corner Code ##
1. Public Land Survey	T 6N R 13W	E-5 (SE cor Section 8) Georgetown Twp
	T ___ R ___	
	T ___ R ___	
	T ___ R ___	
2. Property Controlling	S ___ T ___ R ___	
in Section	S ___ T ___ R ___	
3. Miscellaneous	S ___ T ___ R ___	
Property in Sec.	S ___ T ___ R ___	

Register of Deeds Stamp & File Number

4. Lot No. _____, Recorded Plat _____
5. Private Claims _____

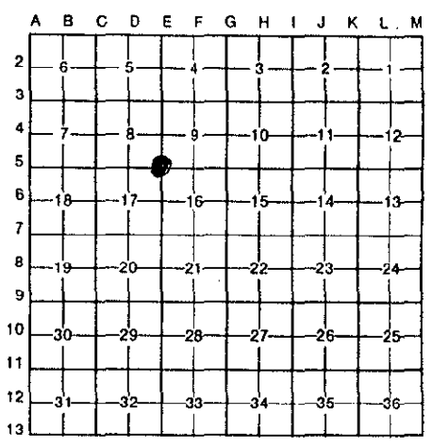

I, Randal J. Vugteveen, in a field survey on November 18, 19 93, do hereby certify that under requirements of P.A. 74, Michigan P.A. of 1970, the corner points mentioned in lines 1 and 2 above were in conformance with regulations and rules therefore as required in the current manual of survey instructions of the United States Department of the Interior, Bureau of Land Management or by a decree of a Court of Law and/or that the corner points mentioned in lines 3, 4 and 5 above were in conformance with the rules of the Michigan Board of Land Surveyors or by a Decree of a Court of Law; established, re-established, monumented, re-monumented, recovered, found as expressed below:

NOTE: Not more than 4 corners, all in the same town and range, may be recorded on this certificate.

A. Description of original monument and accessories and/or subsequent restoration:

E-5 LCRC Liber 2, Page 861	E-5 LCRC Liber 2, Page 395
Nail in W side 24" Twin Maple SSE 125.85'	Found 1" pipe
/ Nail in S side 6" Wild Cherry W 45.70' /	North 0.77 F.P.
Fence post N 0.90' / at intersection of	south 18.05' Apple Clump
E-W & N-S fences	East 2.70' 4" Elm

B. Description of corner evidence found and/or method applied in restoring or reestablishing corner:
Found concrete mon at tree ROW N & S & W woods East, old fence lines N,S, E,W and accepted as a careful and faithful perpetuation of the position of the original corner

Center 24" Twin Maple SSE 126.0'	Found N & T Apple clump SSE 18.23
Center 6" dead Cherry W 46.0'	East 2.60' 4" Elm

C. Description of monument for corner and accessories established to perpetuate locating the position of the corner:
Replaced Concrete Monument with 36" X 3/4" solid rod with Ottawa County Remon Cap

Set Ottawa County Remon Tag & Nail apple clump SSE 18.19'
Set Ottawa County Remon Tag & Nail in N side dead Elm East 2.60'
Set Ottawa County Remon Tag & Nail in N side 10" Apple East 16.77'
Set Ottawa County Remon Tag & Nail in S side 8" Maple West 30.12'

STATE OF MICHIGAN
RANDAL J. VUGTEVEEN
NO. 28429
LICENSED LAND SURVEYOR

Signed by Randal J. Vugteveen Date Dec 6, 1993

Surveyor's Michigan License No. 28429

FORM APPROVED BY MICHIGAN STATE BOARD OF LAND SURVEYORS, JAN. 28, 1971
REVISED MAY 14, 1975
REVISED JAN., 1983