

# SURVEY & REMONUMENTATION

APR 24 1995

OTTAWA COUNTY REMONUMENTATION

RECORDED

COMMISSION

LAND CORNER RECORDATION CERTIFICATE  
Filing Requirement of Act 74, Mich. P.A. 1970

94 DEC 14 AM 9:40

For corners in OTTAWA

*Phyllis Holman*  
REGISTER OF DEEDS  
OTTAWA COUNTY, MI

	Located In:	Corner Code #
1. Public Land Survey	T <u>6N</u> R <u>13W</u>	E-8 (E 1/4 cor of Sec 20) Georgetown Twp.
	T _____ R _____	
	T _____ R _____	
	T _____ R _____	
2. Property Controlling in Section	S _____ T _____ R _____	
	S _____ T _____ R _____	
3. Miscellaneous Property in Sec.	S _____ T _____ R _____	
	S _____ T _____ R _____	

Register of Deeds Stamp & File Number

4. Lot No. \_\_\_\_\_, Recorded Plat \_\_\_\_\_  
5. Private Claims \_\_\_\_\_

	A	B	C	D	E	F	G	H	I	J	K	L	M
2	6	5	4	3	2	1							
3													
4	7	8	9	10	11	12							
5													
6	18	17	16	15	14	13							
7													
8	19	20	21	22	23	24							
9													
10	30	29	28	27	26	25							
11													
12	31	32	33	34	35	36							
13													

I, Randal J. Vugteveen, in a field survey on November 22, 1994, do hereby certify that under requirements of P.A. 74, Michigan P.A. of 1970, the corner points mentioned in lines 1 and 2 above were in conformance with regulations and rules therefore as required in the current manual of survey instructions of the United States Department of the Interior, Bureau of Land Management or by a decree of a Court of Law and/or that the corner points mentioned in lines 3, 4 and 5 above were in conformance with the rules of the Michigan Board of Land Surveyors or by a Decree of a Court of Law; established, re-established, monumented, re-monumented, recovered, found as expressed below:

**NOTE: Not more than 4 corners, all in the same town and range, may be recorded on this certificate.**

A. Description of original monument and accessories and/or subsequent restoration:  
E-8 common corner to Sections 20 & 21

1831 - Lyon & Sibley	Liber 2, page 443
Set H.M.P.	3/4" Iron / SW side fence post with stones
Lynn 7" N26E 26 Links	on N-S fence line / Line fence West S 3.5'
Beech 9" S34W 46 Links	/ 6" Sassafras S 3.6'


B. Description of corner evidence found and/or method applied in restoring or reestablishing corner:  
E-8 Found concrete mon 1' W of 6' wood fence & 170' S of centerline Creekridge Drive and accepted as a careful and faithful perpetuation of the position of the original corner

P.A. 345 OTTAWA COUNTY  
PEER APPROVED 12/12/94

*Madon D. Redwood*

C. Description of monument for corner and accessories established to perpetuate locating the position of the corner:  
E-8 Removed concrete mon, set 3/4" X 36" solid bar with Ottawa County Remon Cap

AZ = Michigan State Grid Direction  
SE corner foundation house #3208 Creekridge Dr. AZ. 345 deg 66.09'  
SW corner foundation garage house #3208 Creekridge Drive AZ. 309 deg 112.66'  
Concrete monument AZ. 180 deg 13.68'  
NE foundation corner of garage behind house #6778 City View Dr. AZ. 208 deg 150.00'  
Concrete monument AZ. 257 deg 102.20'

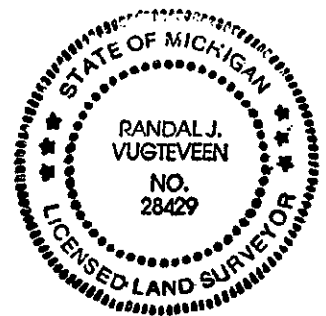

Signed by Randal J. Vugteveen  
Surveyor's Michigan License No. 28429

Date Dec 9, 1994