

SURVEY & REMONUMENTATION

APR 05 1996

OTTAWA COUNTY REMONUMENTATION

COMMISSION

LAND CORNER RECORDATION CERTIFICATE
Filing Requirement of Act 74, Mich. P.A. 1970

For corners in

OTTAWA

(County)

Located In:

Corner Code #

- | | | | |
|------------------------------------|-------------|---------------|--|
| 1. Public Land Survey | T <u>6N</u> | R <u>R13W</u> | F-3 (S 1/4 cor Section 4)
Georgetown Twp. |
| | T _____ | R _____ | _____ |
| | T _____ | R _____ | _____ |
| | T _____ | R _____ | _____ |
| 2. Property Controlling in Section | S _____ | T _____ | _____ |
| | S _____ | T _____ | _____ |
| 3. Miscellaneous Property in Sec. | S _____ | T _____ | _____ |
| | S _____ | T _____ | _____ |

RECORDED

95 NOV 15 PM 2: 12

Rodney Williams
REGISTER OF DEEDS
OTTAWA COUNTY, MI

Register of Deeds Stamp & File Number

4. Lot No. _____, Recorded Plat _____
5. Private Claims _____

I, Randal J. Vugteveen, in a field survey on October 11, 19 95, do hereby certify that under requirements of P.A. 74, Michigan P.A. of 1970, the corner points mentioned in lines 1 and 2 above were in conformance with regulations and rules therefore as required in the current manual of survey instructions of the United States Department of the Interior, Bureau of Land Management or by a decree of a Court of Law and/or that the corner points mentioned in lines 3, 4 and 5 above were in conformance with the rules of the Michigan Board of Land Surveyors or by a Decree of a Court of Law; established, re-established, monumented, re-monumented, recovered, found as expressed below:

NOTE: Not more than 4 corners, all in the same town and range, may be recorded on this certificate.

A	B	C	D	E	F	G	H	I	J	K	L	M
2	6	5	4	3	2	1						
3												
4	7	8	9	10	11	12						
5												
6	18	17	16	15	14	13						
7												
8	19	20	21	22	23	24						
9												
10	30	29	28	27	26	25						
11												
12	31	32	33	34	35	36						
13												

A. Description of original monument and accessories and/or subsequent restoration:

F-3 Common corner to Sections 4 & 9

- | | |
|--------------------------|----------------------|
| 1831 - Sibley | Liber 1, Page 193 |
| Set post | 12" Beech N00W 8.08' |
| Sugar N5 E2 1/2 12 Links | 10" Maple N30W 8.15' |
| Beech S22 W19 5 Links | 8" Maple N50W 32.55' |

B. Description of corner evidence found and/or method applied in restoring or reestablishing corner:

- F-3 Found "T" iron at barb wire fence corne N.E.W. and accepted as a careful and faithful perpetuation of the position of the original corner
- | |
|---|
| Found nail & tag 16" Beech E side 8.94' |
| Found nail in dead 10" Maple N30W 8.87' |
| Found nail in 10" Maple SE face N50W 32.56' |


P.A. 345 OTTAWA COUNTY
PEER APPROVED 10/23/95

Rodney Williams
RD 7

C. Description of monument for corner and accessories established to perpetuate locating the position of the corner:

F-3 Removed "T" iron, set 3/4" x 36" solid bar with Ottawa County Remon cap

- | |
|--|
| Set Ottawa County Remon Nail & Tag on E side 16" Beech North 8.58' |
| Set Ottawa County Remon Nail & Tag on SW side 10" Maple Az. 280 deg 32.77' |
| Set Ottawa County Remon Nail & Tag on S side 14" Ash Az. 240 deg 36.27' |
| Set Ottawa County Remon Nail & Tag on NE side 6" Maple Az. 150 deg 28.10' |

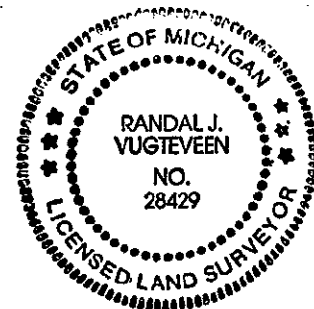

Signed by *Randal J. Vugteveen*
Surveyor's Michigan License No. 28429

Date Oct. 20, 1995