

**SURVEY &
REMONUMENTATION**

OTTAWA COUNTY REMONUMENTATION

OCT 07 1996

LAND CORNER RECORDATION CERTIFICATE

Filing Requirement of Act 74, Mich. P.A. 1970

For corners in **COMMISSION
OTTAWA**

(County)	Located In:	Corner Code #
1. Public Land Survey	T <u>6N</u> R <u>13W</u>	F-11 (S 1/4 of Section 28) Georgetown Twp.
	T _____ R _____	
	T _____ R _____	
	T _____ R _____	
2. Property Controlling in Section	S _____ T _____ R _____	
	S _____ T _____ R _____	
3. Miscellaneous Property in Sec.	S _____ T _____ R _____	
	S _____ T _____ R _____	

RECORDED

96 AUG 26 PM 2:02

Ralph W. Hedewell
REGISTER OF DEEDS
OTTAWA COUNTY, MI

Register of Deeds Stamp & File Number

4. Lot No. _____, Recorded Plat _____
5. Private Claims _____

	A	B	C	D	E	F	G	H	I	J	K	L	M
2	6	5	4	3	2								
3													
4	7	8	9	10	11	12							
5													
6	18	17	16	15	14	13							
7													
8	19	20	21	22	23	24							
9													
10	30	29	28	27	26	25							
11													
12	31	32	33	34	35	36							
13													

I, Randal J. Vugteveen, in a field survey on January 9, 1996, do hereby certify that under requirements of P.A. 74, Michigan P.A. of 1970, the corner points mentioned in lines 1 and 2 above were in conformance with regulations and rules therefore as required in the current manual of survey instructions of the United States Department of the Interior, Bureau of Land Management or by a decree of a Court of Law and/or that the corner points mentioned in lines 3, 4 and 5 above were in conformance with the rules of the Michigan Board of Land Surveyors or by a Decree of a Court of Law; established, re-established, monumented, re-monumented, recovered, found as expressed below:

NOTE: Not more than 4 corners, all in the same town and range, may be recorded on this certificate.

A. Description of original monument and accessories and/or subsequent restoration:
F-11 Common corner to Sections 28 & 33

1832 - Sibley	Liber 1, Page 203 & 204
Set 1/4 Sec. post on true line	MBT Pole S30E 30.48'
Byron S26 E14 18 Links	30" Oak N70W 69.71'
Thorn N 1 1/2 E58 6 Links	Fence Post Due N 31.95'
	CP Pole S50E 85.87'

B. Description of corner evidence found and/or method applied in restoring or reestablishing corner:
F-11 Found 3/4" pipe in mon box on centerline Van Buren and accepted as a careful and faithful perpetuation of the position of the original corner

MBT pole S30E 30.45'
30" Oak N70W 70.6'


P.A. 345 OTTAWA COUNTY
PEER APPROVED 2-19-96

Randy P. Hedewell

C. Description of monument for corner and accessories established to perpetuate locating the position of the corner:

F-11 Removed pipe set 3/4" X 24" solid bar with Ottawa County Remon Cap in mon box

Set Ottawa County Nail & Tag in E side p. pole Az. 342 deg 25.60'
Set Ottawa County Nail & Tag in W side p. pole Az. 161 deg 30.88'
Set Ottawa County Remon Nail & Tag in SE side 8" Ash Az. 60 deg 64.35'
Set Ottawa County Remon Nail & Tag in S side 40" Oak Az. 287 deg 70.56'

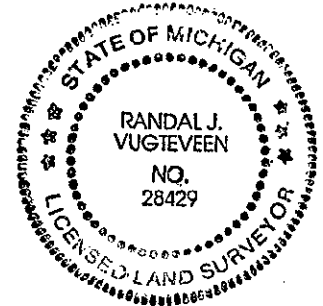

Signed by *Randal J. Vugteveen*
Surveyor's Michigan License No. 28429

Date FEB 19, 1996