

**SURVEY & REMONUMENTATION**

NOV 10 1993

**COMMISSION**

**OTTAWA COUNTY REMONUMENTATION  
LAND CORNER RECORDATION CERTIFICATE  
Filing Requirement of Act 74, Mich. P.A. 1970**

**RECORDED**  
1993 SEP 29 PM 3:14

For corners in Ottawa (County)	Located In:	Corner Code #
1. Public Land Survey	T 6N R 13W	G-4 (E 1/4 cor Section 9) Georgetown Twp
	T R	
	T R	
	T R	
2. Property Controlling in Section	S T R	
	S T R	
3. Miscellaneous Property in Sec.	S T R	
	S T R	

*Randal J. Vugteveen*  
REGISTER OF DEEDS  
OTTAWA COUNTY, MI

Register of Deeds Stamp & File Number

4. Lot No. \_\_\_\_\_, Recorded Plat \_\_\_\_\_  
5. Private Claims \_\_\_\_\_

	A	B	C	D	E	F	G	H	I	J	K	L	M
2	6	5	4	3	2	1							
3													
4	7	8	9	10	11	12							
5													
6	18	17	16	15	14	13							
7													
8	19	20	21	22	23	24							
9													
10	30	29	28	27	26	25							
11													
12	31	32	33	34	35	36							
13													

I, Randal J. Vugteveen, in a field survey on July 16, 19 93, do hereby certify that under requirements of P.A. 74, Michigan P.A. of 1970, the corner points mentioned in lines 1 and 2 above were in conformance with regulations and rules therefore as required in the current manual of survey instructions of the United States Department of the Interior, Bureau of Land Management or by a decree of a Court of Law and/or that the corner points mentioned in lines 3, 4 and 5 above were in conformance with the rules of the Michigan Board of Land Surveyors or by a Decree of a Court of Law; established, re-established, monumented, re-monumented, recovered, found as expressed below:

**NOTE: Not more than 4 corners, all in the same town and range, may be recorded on this certificate.**


**A. Description of original monument and accessories and/or subsequent restoration:**

G-4 1/4 corner common to Sections 9 & 10 Georgetown	LCRC Liber 4 Pg. 107	LCRC Liber 5 Pg. 229
LCRC Liber 1 Pg. 745	Cast Iron Monument inscribed	CI Mon in Mon Box
Iron stake	"Section Corner" P. Pole NE 53.02	PK in P. pole NE 53.00
20" Maple SE 57.53	NW corner house SE 111.12	NW corner hse SSE 111.18
24" Maple S 34.25	26" Maple SE 57.21	Nail & cap on NW side 30" Maple SE 57.24
Face of power pole NE 52.7	T. pole SW 74.49	Nail & cap SE side P. pole WSW 74.

**B. Description of corner evidence found and/or method applied in restoring or reestablishing corner:**

G-4 Found cast iron monument in Mon Box 1' North of centerline X 24th & Bauer and accepted as a careful and faithful perpetuation of the position of the original corner

30" Maple S 35.3	PK in P. pole NE 53.0
	NW corner hse SSE 111.01

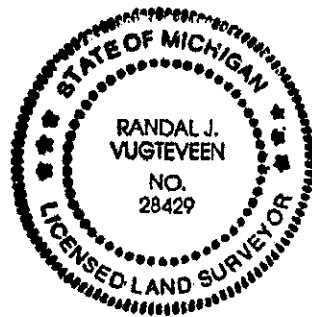

**C. Description of monument for corner and accessories established to perpetuate locating the position of the corner:**

G-4 Set Ottawa County Remon Cap in concrete above cast iron monument in Mon Box

Ottawa County Remon tag & nail in W. side P. pole	N30°E	53.00'
Ottawa County Remon tag & nail in W. side P. pole	N45°W	44.40'
Ottawa County Remon tag & nail in W. side 30" Maple	South	35.35'
Ottawa County Remon tag & nail in N. side 30" Walnut	S75°E	120.21'

Signed by Randal J. Vugteveen Date SEPT 20 1993  
Surveyor's Michigan License No. 28429