

**SURVEY & REMONUMENTATION**

NOV 10 1993

**COMMISSION**

OTTAWA COUNTY REMONUMENTATION

**LAND CORNER RECORDATION CERTIFICATE**  
Filing Requirement of Act 74, Mich. P.A. 1970

For corners in

<u>Ottawa</u> (County)	Located In:	Corner Code #
1. Public Land Survey	T <u>6N</u> R <u>13W</u>	G-6 (E 1/4 cor Section 16) Georgetown Twp
	T _____ R _____	_____
	T _____ R _____	_____
	T _____ R _____	_____
2. Property Controlling in Section	S _____ T _____ R _____	_____
	S _____ T _____ R _____	_____
3. Miscellaneous Property in Sec.	S _____ T _____ R _____	_____
	S _____ T _____ R _____	_____
4. Lot No. _____, Recorded Plat _____		
5. Private Claims _____		

RECORDED

1993 SEP 29 PM 3:14

*Randal J. Vugteveen*  
REGISTER OF DEEDS  
OTTAWA COUNTY, MI

Register of Deeds Stamp & File Number

I, Randal J. Vugteveen in a field survey on July 16, 19 93, do hereby certify that under requirements of P.A. 74, Michigan P.A. of 1970, the corner points mentioned in lines 1 and 2 above were in conformance with regulations and rules therefore as required in the current manual of survey instructions of the United States Department of the Interior, Bureau of Land Management or by a decree of a Court of Law and/or that the corner points mentioned in lines 3, 4 and 5 above were in conformance with the rules of the Michigan Board of Land Surveyors or by a Decree of a Court of Law; established, re-established, monumented, re-monumented, recovered, found as expressed below:

A	B	C	D	E	F	G	H	I	J	K	L	M
2	6	5	4	3	2	1						
3												
4	7	8	9	10	11	12						
5												
6	13	17	15	15	14	13						
7												
8	19	20	21	22	23	24						
9												
10	30	29	28	27	26	25						
11												
12	31	32	33	34	35	36						
13												

**NOTE: Not more than 4 corners, all in the same town and range, may be recorded on this certificate.**

A. Description of original monument and accessories and/or subsequent restoration:

G-6 1/4 corner common to Sections 15 & 16 Georgetown

LCRC Liber 1, Pg. 115	LCRC Liber 1, Pg. 631	LCRC Liber 3, Pg. 33
Boat spike in mon box	Boat spike in mon box	Iron
W hse cor NE 85.81'	NE P.P. 96.49'	PK nail in W side of P. Pole S05°E 25.7'
E cor attached gar NE 117.44'	S. T.P. 25.81'	Nail in NW side of 14" Oak S30°W 47.00'
W hse corner SE 79.97'	SW 14' Oak 47.0'	SW cor of hse #2395 Baldwin N10°E 85.05'
E hse corner SW 105.87'		

B. Description of corner evidence found and/or method applied in restoring or reestablishing corner:

G-6 Found cast iron mon in mon box on centerline Baldwin between Coconut & Roselane and accepted as a careful and faithful perpetuation of the position of the original corner

E corner brick hse #2395	SW cor hse #2395 N25°E 84.94'
N45°E 117.44'	
ound P.K. in S side P.Pole	
N60°E 96.29'	


C. Description of monument for corner and accessories established to perpetuate locating the position of the corner:

G-6 Set Ottawa County Remon Cap on 5" X 3/4" pipe cemented in mon box

Ottawa County Remon tag & nail in S side p. pole	N60°E	96.29'
SE corner brk hse #2395	N45°E	117.29'
NW corner hse foundation hse #2390	S20°E	78.87'
NE corner hse foundation hse #7588	S40°W	105.96'

Signed by *Randal J. Vugteveen*  
Surveyor's Michigan License No. 28429

Date Sept 20, 1993

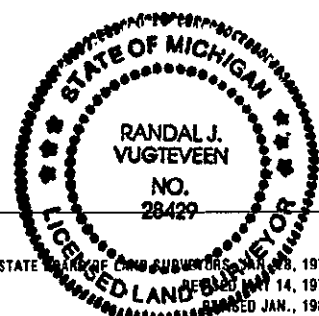

FORM APPROVED BY MICHIGAN STATE BOARD OF LAND SURVEYORS, 1971  
REVISED JAN., 1983