

SURVEY & REMONUMENTATION

APR 24 1995

COMMISSION

OTTAWA COUNTY REMONUMENTATION

LAND CORNER RECORDATION CERTIFICATE
Filing Requirement of Act 74, Mich. P.A. 1970

RECORDED

94 DEC 14 AM 9:41

Regina K. Kellman
REGISTER OF DEEDS
OTTAWA COUNTY, MI

For corners in OTTAWA

(County)

Located In:

Corner Code #

- | | | | | | |
|------------------------------------|---|----|---|-----|--|
| 1. Public Land Survey | T | 6N | R | 13W | G-13 (SE cor of Sec 33)
Georgetown Twp. |
| | T | | R | | |
| | T | | R | | |
| | T | | R | | |
| 2. Property Controlling in Section | S | | T | R | |
| | S | | T | R | |
| 3. Miscellaneous Property in Sec. | S | | T | R | |
| | S | | T | R | |

Register of Deeds Stamp & File Number

4. Lot No. _____, Recorded Plat _____
5. Private Claims _____

	A	B	C	D	E	F	G	H	I	J	K	L	M
2	6		5		4		3		2		1		
3													
4	7		8		9		10		11		12		
5													
6	18		17		16		15		14		13		
7													
8	19		20		21		22		23		24		
9													
10	30		29		28		27		26		25		
11													
12	31		32		33		34		35		36		
13													

I, Randal J. Vugteveen, in a field survey on November 30, 1994, do hereby certify that under requirements of P.A. 74, Michigan P.A. of 1970, the corner points mentioned in lines 1 and 2 above were in conformance with regulations and rules therefore as required in the current manual of survey instructions of the United States Department of the Interior, Bureau of Land Management or by a decree of a Court of Law and/or that the corner points mentioned in lines 3, 4 and 5 above were in conformance with the rules of the Michigan Board of Land Surveyors or by a Decree of a Court of Law; established, re-established, monumented, re-monumented, recovered, found as expressed below:

NOTE: Not more than 4 corners, all in the same town and range, may be recorded on this certificate.

A. Description of original monument and accessories and/or subsequent restoration:
G-13 common corner to Sections 33 & 34

1831 - Lyon & Sibley	Liber 2, Page 321	Liber 2, Page 703
Set post	Power Pole ESE 148.3'	N edge of conc pavement SW 59.23'
Beech 16" N33W 31 Links	Fence Post S 10.9'	C/L Mich-Wis gas line pipe W 64.60'
Beech 6" N81E 17 Links	Orange painted fence post WSW 58.4'	SE cor garage NW 184.80'
	Orange painted fence post N 80.2'	
	Cor hse WSW 228.5'	

B. Description of corner evidence found and/or method applied in restoring or reestablishing corner:
G-13 Found 1/2" bar 59' N of N edge of conc of West bound I196 & 330' East of centerline of S end of 24th Avenue and accepted as a careful and faithful perpetuation of the position of the original corner


N edge of conc pavement SW 59.23'
C/L Mich-Wis gas line pipe W 64.47'
SE cor garage NW 184.84'

P.A. 345 OTTAWA COUNTY
PEER APPROVED 12/12/94

Randolph P. Nedewald

C. Description of monument for corner and accessories established to perpetuate locating the position of the corner:
G-13 Removed 1/2" bar, set 3/4" X 36" solid bar with Ottawa County Remon cap in mon box (Held as Common corner with G-1 Jamestown Twp per LCRC witnesses and Ottawa Co. Surveyor notes
AZ = Michigan State Grid Direction

North edge concret West bound I-196 AZ. 145 deg 59.18'
Set Ottawa County Remon Tag & nail in E side corner fence post AZ. 0 deg 38.08'
Centerline 8" pipe 1' above ground (candy cane shape) AZ. 280 deg 139.02'
SE foundation corner garage to house #4822 24th Avenue AZ. 285 deg 184.84'

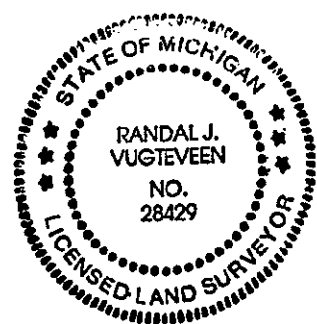

Signed by *Randal J. Vugteveen*
Surveyor's Michigan License No. 28429

Date Dec 12, 1994