

SURVEY & REMONUMENTATION

APR 24 1995

OTTAWA COUNTY REMONUMENTATION

RECORDED

COMMISSION

LAND CORNER RECORDATION CERTIFICATE

94 DEC 14 AM 10:02

Filing Requirement of Act 74, Mich. P.A. 1970

For corners in OTTAWA

D. J. Vugteveen
REGISTER OF DEEDS
OTTAWA COUNTY, MI

	Located In:		Corner Code #
(County)	T	R	
1. Public Land Survey	6N	13W	H-13 (S 1/4 cor of Sec 34) Georgetown Twp.
	T	R	
	T	R	
	T	R	
2. Property Controlling in Section	S	T	R
	S	T	R
3. Miscellaneous Property in Sec.	S	T	R
	S	T	R

Register of Deeds Stamp & File Number

4. Lot No. _____, Recorded Plat _____
5. Private Claims _____

	A	B	C	D	E	F	G	H	I	J	K	L	M
2	6	5	4	3	2	1							
3													
4	7	8	9	10	11	12							
5													
6	18	17	16	15	14	13							
7													
8	19	20	21	22	23	24							
9													
10	30	29	28	27	26	25							
11													
12	31	32	33	34	35	36							
13													

I, Randal J. Vugteveen in a field survey on November 30, 1994 do hereby certify that under requirements of P.A. 74, Michigan P.A. of 1970, the corner points mentioned in lines 1 and 2 above were in conformance with regulations and rules therefore as required in the current manual of survey instructions of the United States Department of the Interior, Bureau of Land Management or by a decree of a Court of Law and/or that the corner points mentioned in lines 3, 4 and 5 above were in conformance with the rules of the Michigan Board of Land Surveyors or by a Decree of a Court of Law; established, re-established, monumented, re-monumented, recovered, found as expressed below:

NOTE: Not more than 4 corners, all in the same town and range, may be recorded on this certificate.

A. Description of original monument and accessories and/or subsequent restoration:
H-13 common corner to Section 34

1831 - Lyon & Sibley	Liber 2, Page 197	Liber 5, Page 72
Set H.M.P.	Spike in side 24" Basswood SW 28.56'	8" Basswood NE 75.70'
Sugar 7" N12W 8 Links	Spike in side 30" Maple NNE 69.32'	Fence post NNW 26.00'
Elm 20" N48E 2 Links	MSHD nail in side 12" Basswood WNW 44.38'	6" Ash SW 110.4'
		Jamestown cor E 8.2'


B. Description of corner evidence found and/or method applied in restoring or reestablishing corner:
H-13 Found broken CIM 2' South of centerline of Jackson Street and accepted as a careful and faithful perpetuation of the position of the original corner

8" Basswood NE 75.72'
Fence post NNW 26'
6" Ash SW 110.46'
Jamestown corner E 8.18' CIM

P.A. 345 OTTAWA COUNTY
PEER APPROVED 12/12/94
Randal J. Vugteveen

C. Description of monument for corner and accessories established to perpetuate locating the position of the corner:
H-13 Cast Iron Monument

AZ = Michigan State Grid Direction
Set Ottawa County Remon Tag & Nail in SE side P. pole AZ. 45 deg 42.00'
Set Ottawa County Remon Tag & Nail in NW side 8" Ash AZ. 235 deg 110.46'
Set Ottawa County Remon Tag & Nail in E side 10" Wild Cherry AZ. 317 deg 88.20
CIM AZ. 90 deg 8.18' (Jamestown Corner)

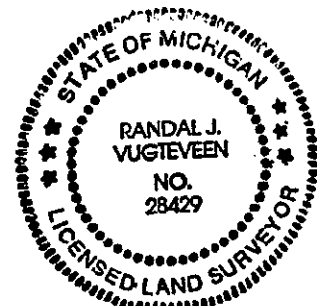

Signed by *Randal J. Vugteveen*

Date Dec 12, 1994

Surveyor's Michigan License No. 28429