

**SURVEY &  
REMONUMENTATION**

OTTAWA COUNTY REMONUMENTATION

RECORDED

DEC 01 1993

93 NOV 11 AM 11:53

**LAND CORNER RECORDATION CERTIFICATE  
Filing Requirement of Act 74, Mich. P.A. 1970**

For corners in **COMMISSION  
OTTAWA**

*Ralph J. Vugteveen*  
REGISTER OF DEEDS  
OTTAWA COUNTY, MI

(County)	Located In:	Corner Code #
1. Public Land Survey	T <u>6N</u> R <u>13W</u>	I-3 (NE COR Section 10) Georgetown Twp
	T _____ R _____	
	T _____ R _____	
	T _____ R _____	
2. Property Controlling in Section	S _____ T _____ R _____	
	S _____ T _____ R _____	
3. Miscellaneous Property in Sec.	S _____ T _____ R _____	
	S _____ T _____ R _____	
4. Lot No. _____, Recorded Plat _____		
5. Private Claims _____		

Register of Deeds Stamp & File Number

I, Randal J. Vugteveen, in a field survey on August 3, 1993, do hereby certify that under requirements of P.A. 74, Michigan P.A. of 1970, the corner points mentioned in lines 1 and 2 above were in conformance with regulations and rules therefore as required in the current manual of survey instructions of the United States Department of the Interior, Bureau of Land Management or by a decree of a Court of Law and/or that the corner points mentioned in lines 3, 4 and 5 above were in conformance with the rules of the Michigan Board of Land Surveyors or by a Decree of a Court of Law; established, re-established, monumented, re-monumented, recovered, found as expressed below:

A	B	C	D	E	F	G	H	I	J	K	L	M
2	6	5	4	3	2	1						
3												
4	7	8	9	10	11	12						
6												
6	18	17	16	15	14	13						
7												
8	19	20	21	22	23	24						
9												
10	30	29	28	27	26	25						
11												
12	31	32	33	34	35	36						
13												

**NOTE: Not more than 4 corners, all in the same town and range, may be recorded on this certificate.**

**A. Description of original monument and accessories and/or subsequent restoration:  
I-3 Common corner to Sections 2, 3, 10 & 11**


LCRC Liber 1, Page 741	LCRC Liber 6, Page 24	LCRC Liber 6, Page 206
R.R. spike in Mon box	Cast iron monument	Cast Iron Monument
Nail in P. Pole N-NW 97.74'	24" Maple W-SW 29.36'	Nail in W side 24" Walnut N10E 95.65' /
Nail in T. Pole NW 101.13'	P. Pole N-NW 97.42'	Nail in NE side P. Pole S50E 115.65' /
Nail in 22" Maple W-SW 29.70'	T. Pole NW 100.94'	Nail in SE side 20" Pine S 75.72' / Nail
	L. Pole SE 115.60'	in SE side 24" Maple S45W 29.35' / Nail in
		E side P. Pole N70W 100.88'

**B. Description of corner evidence found and/or method applied in restoring or reestablishing corner:  
I-3 Found cast iron monument in monument box at centerline "X", Cottonwood & Taylor and accepted as a careful and faithful perpetuation of the position of the original corner**

PK in W side P. Pole N25W 97.57'	PK in W side P. Pole N25W 97.57'	Nail in W side 24" Walnut N10E 95.62' /
		Nail in NE side P. Pole S50E 115.61' /
		Nail in E side P. Pole N70W 100.85' / Nail
		in SE side 20" Pine S4E 75.71'

**C. Description of monument for corner and accessories established to perpetuate locating the position of the corner:  
I-3 Set Ottawa County Remon cap on monument with concrete in mon box**

- Set Ottawa County Remon Tag & Nail in SE side 24" Maple S50W 29.41'
- Set Ottawa County Remon Tag & Nail in E side 20" Pine S4E 75.33'
- Set Ottawa County Remon Tag & Nail in NE side L. Pole S63E 115.60'
- Set Ottawa County Remon Tag & Nail in NW side 24" Walnut N7E 96.36'
- NE cor brick house #8791 S15E 160.68'
- SE cor brick house #8825 N75W 146.01'

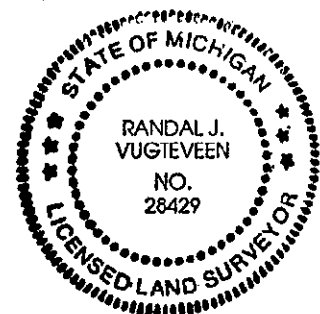

Signed by *Randal J. Vugteveen* Date Nov 5, 1993  
Surveyor's Michigan License No. 28429