

**SURVEY & REMONUMENTATION**

OTTAWA COUNTY REMONUMENTATION

RECORDED

DEC 01 1993

93 NOV 11 AM 11:51

**LAND CORNER RECORDATION CERTIFICATE**

Filing Requirement of Act 74, Mich. P.A. 1970

*Randy J. Vugteven*  
REGISTER OF DEEDS  
OTTAWA COUNTY, MI

For corners in **COMMISSION**  
**OTTAWA**

(County)	Located In:	Corner Code #
1. Public Land Survey	T <u>6N</u> R <u>13W</u>	I-6 (E 1/4 cor Section 15) Georgetown Twp
	T _____ R _____	
	T _____ R _____	
	T _____ R _____	
2. Property Controlling in Section	S _____ T _____ R _____	
	S _____ T _____ R _____	
3. Miscellaneous Property in Sec.	S _____ T _____ R _____	
	S _____ T _____ R _____	
4. Lot No. _____, Recorded Plat _____		
5. Private Claims _____		

Register of Deeds Stamp & File Number

I, Randal J. Vugteven, in a field survey on August 3, 19 93, do hereby certify that under requirements of P.A. 74, Michigan P.A. of 1970, the corner points mentioned in lines 1 and 2 above were in conformance with regulations and rules therefore as required in the current manual of survey instructions of the United States Department of the Interior, Bureau of Land Management or by a decree of a Court of Law and/or that the corner points mentioned in lines 3, 4 and 5 above were in conformance with the rules of the Michigan Board of Land Surveyors or by a Decree of a Court of Law; established, re-established, monumented, re-monumented, recovered, found as expressed below:

**NOTE: Not more than 4 corners, all in the same town and range, may be recorded on this certificate.**

	A	B	C	D	E	F	G	H	I	J	K	L	M
2	6	5	4	3	2								
3													
4	7	8	9	10	11	12							
5													
6	13	17	16	15	14	13							
7													
8	19	20	21	22	23	24							
9													
10	30	29	28	27	26	25							
11													
12	31	32	33	34	35	36							
13													

**A. Description of original monument and accessories and/or subsequent restoration:**

I-6 Common 1/4 corner to Sections 14 & 15  
LCRC Liber 1, Page 447 | LCRC Liber 2, Page 351  
Iron bar in mon box | 1/2" Pipe in box  
NW cor hse foundation SE 100.85' | Centerline Bell Sys MH in sidewalk S30E  
SE cor gar NW 116.75' | 30.02' / Face of 20" Maple SSE 57.7' / Nail  
Nail in S side 16" Maple N-NE 107.70' | lin NE side T. Pole S70E 77.56' / Nail in  
NE cor hse SW 108.49' | NE side P. Pole N40W 62.82'

**B. Description of corner evidence found and/or method applied in restoring or reestablishing corner:**


I-6 Found capped iron in mon box at centerline "X" of Baldwin & Ridgewood and accepted as a careful and faithful perpetuation of the position of the original corner

NE cor brick hse #1612 S42W 108.22' | Centerline Mich Bell MH in sidewalk S19E  
SE cor gar N43W 116.67' | 29.91'

**C. Description of monument for corner and accessories established to perpetuate locating the position of the corner:**

I-6 Set Ottawa County Remon Cap on 3/4" X 3/4" Rod cemented in mon box

Set Ottawa County Remon Tag & Nail in W side P. Pole N35W 61.20'  
Set Ottawa County Remon Tag & Nail in W side 24" Maple N21E 108.02'  
Set Ottawa County Remon Tag & Nail in S side P. Pole N67E 136.71'  
Set Ottawa County Remon Tag & Nail in S side P. Pole S72E 80.04'  
NE corner brick house #1612 S42W 108.22'

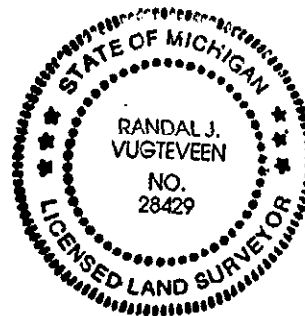

igned by *Randal J. Vugteven* Date Nov 5, 1993  
urveyor's Michigan License No. 28429