

**SURVEY &  
REMONUMENTATION**

**APR 05 1996  
COMMISSION**

OTTAWA COUNTY REMONUMENTATION

**RECORDED**

**LAND CORNER RECORDATION CERTIFICATE  
Filing Requirement of Act 74, Mich. P.A. 1970**

95  
DEC 19 PM 4:42

For corners in  
OTTAWA  
(County)

Located In: \_\_\_\_\_ Corner Code # \_\_\_\_\_

*R. J. Vugteveen*  
REGISTER OF DEEDS  
OTTAWA COUNTY, MI


- |                                       |    |     |   |
|---------------------------------------|----|-----|---|
| 1. Public Land Survey                 | 6N | 13W | J-3 (S 1/4 cor<br>Section 2)<br>Georgetown Twp. |
|                                       | T  | R   | _____   |
|                                       | T  | R   | _____   |
|                                       | T  | R   | _____   |
| 2. Property Controlling<br>in Section | S  | T   | R   |
|                                       | S  | T   | R   |
| 3. Miscellaneous<br>Property in Sec.  | S  | T   | R   |
|                                       | S  | T   | R   |

Register of Deeds Stamp & File Number

4. Lot No. \_\_\_\_\_, Recorded Plat \_\_\_\_\_  
5. Private Claims \_\_\_\_\_

I, Randal J. Vugteveen, in a field survey on October 11, 19 95, do hereby certify that under requirements of P.A. 74, Michigan P.A. of 1970, the corner points mentioned in lines 1 and 2 above were in conformance with regulations and rules therefore as required in the current manual of survey instructions of the United States Department of the Interior, Bureau of Land Management or by a decree of a Court of Law and/or that the corner points mentioned in lines 3, 4 and 5 above were in conformance with the rules of the Michigan Board of Land Surveyors or by a Decree of a Court of Law; established, re-established, monumented, re-monumented, recovered, found as expressed below:

**NOTE: Not more than 4 corners, all in the same town and range, may be recorded on this certificate.**

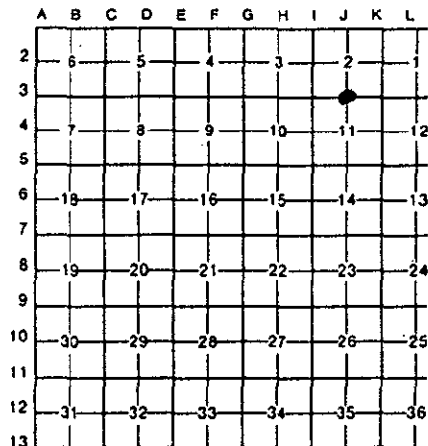

**A. Description of original monument and accessories and/or subsequent restoration:**

J-3 Common corner to Sections 2 & 11

- |                        |   |                               |
|------------------------|---|-------------------------------|
| 1831 - Sibley          | Liber 6, Page 209                       | Liber 5, Page 245             |
| Set HMP                | Replaced cast mon                       | Set CIM                       |
| W. Oak S32 E12.9 Links | SW cor brick hs N45°E 117.71'           | 16" Walnut NE 138.57'         |
| Pine N63 W10 20 Links  | C/L top of fire hyd N60°E 44.39'        | PP WNW 51.92'                 |
|                        | 16-D NW side quad 4" maple S50°W 55.18' | PP ENE 73.50'                 |
|                        | Nail & tag NE side PP N50°W 51.92'      | Center of St. sign SSE 16.95' |
|                        | 1/2" Rebar N25°W 74.07'                 |                               |
|                        | C/L top of fire hyd S60°W 161.20'       |                               |
|                        | Nail & tag NW side PP N70°E 73.52'      |                               |

**B. Description of corner evidence found and/or method applied in restoring or reestablishing corner:**


- J-3 Found PK nail in bit 1' South of centerline Taylor & on centerline 12th Ave and accepted as a careful and faithful perpetuation of the position of the original corner
- SW corner brick house N34E 117.60'
- C/L top of fire hydrant AZ 56 deg 44.30'
- Nail & tag NE side PP AZ 297 deg 51.93'
- C/L to of fire hydrant AZ 252 deg 161.32'
- Nail & tag NW side pp AZ 71 deg 73.48'

P.A. 345 OTTAWA COUNTY  
PEER APPROVED 12/11/95  
*Randal J. Vugteveen*  
RJV

**C. Description of monument for corner and accessories established to perpetuate locating the position of the corner:**

J-3 Replaced PK with 3/4" X 3' steel bar with Ottawa County Remonumentation cap and placed monument box

- SW corner brick house #1185 Taylor St. Az. 34 deg 117.60'
- NW corner siding house #1155 Lumina Dr. Az. 146 deg 139.18'
- NE corner foundation house #1213 Lumina Dr. Az. 206 deg 135.03'
- Set Ottawa County Remon Nail & Tag on NE side p. pole Az. 297 deg 51.90'

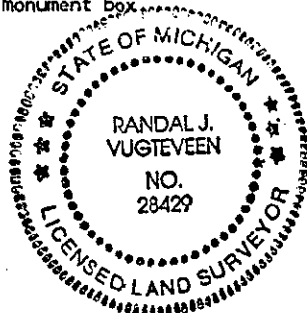

Signed by *Randal J. Vugteveen*  
Surveyor's Michigan License No. 28429

Date Dec 11, 1995