

SURVEY & REMONUMENTATION

DEC 01 1998

Ottawa County Remonumentation

RECORDED

LAND CORNER RECORDATION CERTIFICATE
Filing Requirement of Act 74, Mich. P.A. 1970

98 MAY 22 PM 4:06

SECTION

For corners in

<u>Ottawa</u> (County)	Located In:	Corner Code #
1. Public Land Survey	T <u>6N</u> R <u>13W</u>	<u>J-9 (N$\frac{1}{2}$, 26)</u> <u>Georgetown Twp.</u>
	T _____ R _____	_____
	T _____ R _____	_____
	T _____ R _____	_____
2. Property Controlling in Section	S _____ T _____ R _____	_____
	S _____ T _____ R _____	_____
3. Miscellaneous Property in Sec.	S _____ T _____ R _____	_____
	S _____ T _____ R _____	_____
4. Lot No. _____, Recorded Plat _____		
5. Private Claims _____		

Sam Schiller
REGISTER OF DEEDS
OTTAWA COUNTY, MI

Register of Deeds Stamp & File Number

I, John C. Bueche, in a field survey on March 2, 19 98, do hereby certify that under requirements of P.A. 74, Michigan P.A. of 1970, the corner points mentioned in lines 1 and 2 above were in conformance with regulations and rules therefore as required in the current manual of survey instructions of the United States Department of the Interior, Bureau of Land Management or by a decree of a Court of Law and/or that the corner points mentioned in lines 3, 4 and 5 above were in conformance with the rules of the Michigan Board of Land Surveyors or by a Decree of a Court of Law; established, re-established, monumented, re-monumented, recovered, found as expressed below:

A	B	C	D	E	F	G	H	I	J	K	L	M
2	6	5	4	3	2	1						
3												
4	7	8	9	10	11	12						
5												
6	18	17	16	15	14	13						
7												
8	19	20	21	22	23	24						
9												
10	30	29	28	27	26	25						
11												
12	31	32	33	34	35	36						
13												

NOTE: Not more than 4 corners, all in the same town and range, may be recorded on this certificate.

A. Description of original monument and accessories and/or subsequent restoration:

J-9	Wit. map, no date	Exxel, 1993
Lucius Lyon, 1831	Iron in fence cor.	"T" fence in conc.
Set on true line	Fence N, S & W	NE cor. brick garg. WSW 67.22'
Sugar 12 S 84 W 3 1/2	SE cor. hse. SW 112.12'	SW cor. hse. frnd. NE 112.62'
Sugar 12 S 85 E 48	18" W. Cherry W 9.20'	Dbl. head nail in N side twin
	SE cor. garg. NW 115.75'	24" W. Cherry W 9.83'

OVER

B. Description of corner evidence found and/or method applied in restoring or reestablishing corner:

J-9 Found "T" fence post in conc. (big)

As per above wit.

As per above wit.


And is accepted as a careful and faithful perpetuation of the position of the original corner.

P.A. 345 OTTAWA COUNTY

PEER APPROVED 4/20/98

C. Description of monument for corner and accessories established to perpetuate locating the position of the corner:

J-9 Placed Ottawa Co. Cap on top of "T" fence post in conc.
Dbl. head nail in N side 28" W. Cherry N 85° W 9.83'
SW cor. frnd. to hse. N 45° E 112.62'
NW cor. frame (wood) bldg. S 75° E 68.80'
SE cor. hse. brick S 30° W 112.12'
NE cor. garg. brick S 70° W 67.22'

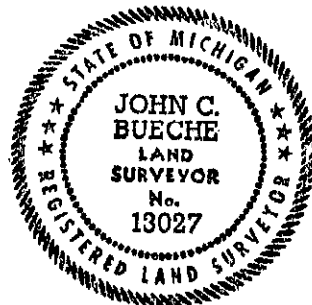

4 11.00 CORNER
4 2.00 PHOTO
4 2.00 PHOTO

Signed by John C. Bueche
John C. Bueche, P.S. 13027

Date 3-13-98

Surveyor's Michigan License No. _____

FORM APPROVED BY MICHIGAN STATE BOARD OF LAND SURVEYORS, JAN. 28, 1971
REVISED MAY 14, 1975
REVISED JAN., 1983

SURVEY &
REMONUMENTATION

DEC 01 1998

PART A - continued

SECTION

Corner is the SE cor. of VanderKooy Subdivision, recorded in 1952

Corner is 52.3' South of the SW corner of Wrenwood Estates, recorded in 1965