

SURVEY & REMONUMENTATION

APR 24 1995

OTTAWA COUNTY REMONUMENTATION

RECORDED

94 DEC 14 AM 10:02

COMMISSION

LAND CORNER RECORDATION CERTIFICATE

Filing Requirement of Act 74, Mich. P.A. 1970

Robert K. Williams
REGISTER OF DEEDS
OTTAWA COUNTY, MI

For corners in OTTAWA

(County)

Located in:

Corner Code #

1. Public Land Survey	T	6N	R	13W	J-11 (S 1/4 cor
	T		R		Section 26)
	T		R		Georgetown Twp.
	T		R		
2. Property Controlling in Section	S		T	R	
	S		T	R	
3. Miscellaneous Property in Sec.	S		T	R	
	S		T	R	

Register of Deeds Stamp & File Number

4. Lot No. _____, Recorded Plat _____
5. Private Claims _____

	A	B	C	D	E	F	G	H	I	J	K	L	M
2	6		5		4		3		2				
3													
4	7		8		9		10		11		12		
5													
6	18		17		16		15		14		13		
7													
8	19		20		21		22		23		24		
9													
10	30		29		28		27		26		25		
11													
12	31		32		33		34		35		36		
13													

I, Randal J. Vugteveen, in a field survey on December 7, 1994, do hereby certify that under requirements of P.A. 74, Michigan P.A. of 1970, the corner points mentioned in lines 1 and 2 above were in conformance with regulations and rules therefore as required in the current manual of survey instructions of the United States Department of the Interior, Bureau of Land Management or by a decree of a Court of Law and/or that the corner points mentioned in lines 3, 4 and 5 above were in conformance with the rules of the Michigan Board of Land Surveyors or by a Decree of a Court of Law, established, re-established, monumented, re-monumented, recovered, found as expressed below:

NOTE: Not more than 4 corners, all in the same town and range, may be recorded on this certificate.

A. Description of original monument and accessories and/or subsequent restoration:

J-11 Common corner to Sections 26 & 35

1831 - Lyon & Sibley
Set post
Elm 20" S40W 15 Links
Sugar 7" N12W 23 Links

| Liber 1, Page 335
| MSHD tag in side of 28" Beech NE 18.88'
| Nail in side of 16" Maple N 43.47'
| Nail in 12" Maple WNW 46.33'
| Nail in side of 6" Elm SW 18.59'
| New E & W fence N 11.7'

| Liber 2, Page 99
| 1/2" solid iron
| MSHD tag in side 28" Beech NE 18.86'
| Nail in side 8" Maple SW 18.53'
| Nail in side 14" Maple N 43.43'
| E & W fence N 11.7'

B. Description of corner evidence found and/or method applied in restoring or reestablishing corner:
J-11 Found 1/2" solid bar 1.3' South and 0.5' East of fence corner N & W and accepted as a careful and faithful perpetuation of the position of the original corner


MSHD tag in side of 28" Beech NE 18.88'	MSHD tag in side 28" Beech NE 19.07'
Nail in C/L 20" Maple WNW 46.3'	Nail in side 8" Basswood SW 18.80'
	Hole in side of 20" Maple N 43.4'

P.A. 345 OTTAWA COUNTY
PEER APPROVED 12/12/94

Randal J. Vugteveen

C. Description of monument for corner and accessories established to perpetuate locating the position of the corner:
J-11 Removed 1/2" bar, set 3/4" X 36" bar with Ottawa County Remon Cap

AZ = Michigan State Grid Direction
Set Ottawa County Remon Tag & Nail in E side RR tie fence post corner AZ. 0 deg 1.32'
Set Ottawa County Remon Tag & Nail in SE side 18" Basswood AZ. 220 deg 18.83'
Set Ottawa County Remon Tag & Nail in S side 14" Basswood AZ. 270 deg 22.07'
Set Ottawa County Remon Tag & Nail in NW side 10" Basswood AZ. 45 deg 51.28'

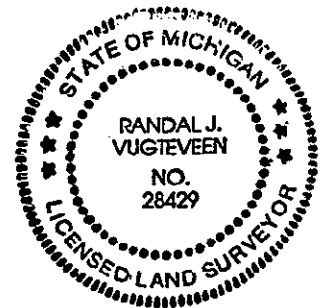

Signed by Randal J. Vugteveen
Surveyor's Michigan License No. 28429

Date Dec. 12, 1994