

**SURVEY & REMONUMENTATION**

**OTTAWA COUNTY REMONUMENTATION**

**APR 05 1996**

**COMMISSION**

**LAND CORNER RECORDATION CERTIFICATE  
Filing Requirement of Act 74, Mich. P.A. 1970**

For corners in  
**OTTAWA**  
(County)

Located In:	Corner Code #
T6N R13W	J-13 (S 1/4 cor Section 35) Georgetown Twp.
T ___ R ___	_____
T ___ R ___	_____
T ___ R ___	_____
S ___ T ___	_____
S ___ T ___	_____
S ___ T ___	_____
S ___ T ___	_____

**RECORDED**

**95 NOV 15 PM 2:11**

*Deborah A. Hollman*  
**REGISTER OF DEEDS  
OTTAWA COUNTY, MI**

**Register of Deeds Stamp & File Number**

4. Lot No. \_\_\_\_\_, Recorded Plat \_\_\_\_\_  
5. Private Claims \_\_\_\_\_

	A	B	C	D	E	F	G	H	I	J	K	L	M
2	6	5	4	3	2	1							
3													
4	7	8	9	10	11	12							
5													
6	16	17	18	15	14	13							
7													
8	19	20	21	22	23	24							
9													
10	30	29	28	27	26	25							
11													
12	31	32	33	34	35	36							
13													

I, Randal J. Vugteveen, in a field survey on October 19, 19 95, do hereby certify that under requirements of P.A. 74, Michigan P.A. of 1970, the corner points mentioned in lines 1 and 2 above were in conformance with regulations and rules therefore as required in the current manual of survey instructions of the United States Department of the Interior, Bureau of Land Management or by a decree of a Court of Law and/or that the corner points mentioned in lines 3, 4 and 5 above were in conformance with the rules of the Michigan Board of Land Surveyors or by a Decree of a Court of Law; established, re-established, monumented, re-monumented, recovered, found as expressed below:

**NOTE: Not more than 4 corners, all in the same town and range, may be recorded on this certificate.**

**A. Description of original monument and accessories and/or subsequent restoration:**  
J-13 Common corner to Section 35

1831 - Sible	Liber 4, Page 347	Liber 1, Page 449
Set HMP	Set CIM	MSHD tag in pp NW 70.86'
Beech N58 1/2 E63 5 Links	PP NW 70.90'	NSHD tag in guy pole SW 58.11'
Beech N52 W10 24 Links	SW cor garage NE 77.62'	Nail in t pole ESE 51.93'
	centerline hyd NE 39.64'	SW corner garage NE 77.84'
	Centerline t.p. SW 59.50'	
	Jamestown cor W 8.14'	

**B. Description of corner evidence found and/or method applied in restoring or reestablishing corner:**  
J-13 Found CIM in mon box @ centerline "X" Jackson St. & 12th Ave North and accepted as a careful and faithful perpetuation of the position of the original corner


Found CIM  
P. pole NW 70.88'  
Centerline Hydrant Az. 39 deg 39.62'  
Jamestown corner West 8.14'

**P.A. 345 OTTAWA COUNTY  
PEER APPROVED 10/23/95**

*Randal J. Vugteveen*

**C. Description of monument for corner and accessories established to perpetuate locating the position of the corner:**  
J-13 Cast Iron Monument

CIM in mon box (Jamestown Corner) Az. 267 deg 8.14'  
Set Ottawa County Remon Nail & Tag above MSHD Nail & Tag in NE side p. pole Az. 327 deg 70.88'  
Set Ottawa County Remon Nail & Tag in NW side 10" Ash Az. 36 deg 107.20'  
NW corner brick garage #1188 Az. 147 deg 125.81'  
Set Ottawa County Remon Nail & Tag N. side P. pole Az. 258 deg 110.19'

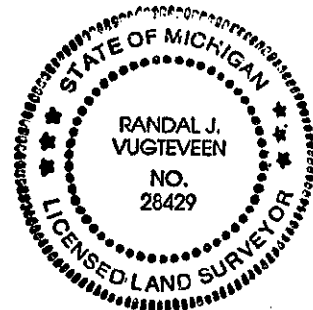

Signed by *Randal J. Vugteveen*  
Surveyor's Michigan License No. 28429

Date Oct. 20, 1995