

SURVEY & REMONUMENTATION

DEC 01 1998

SECTION

**OTTAWA COUNTY REMONUMENTATION
LAND CORNER RECORDATION CERTIFICATE
Filing Requirement of Act 74, Mich. P.A. 1970**

For corners in

| | | |
|---------------------------------------|-----------------------------------|--|
| <u>Ottawa</u> (County) | Located in: Tallmadge Township | Corner Code # <u>K-1</u> NW Cor., Sec. 1 |
| 1. Public Land Survey | T <u>6N</u> R <u>13W</u> | <u>K-1</u> |
| | T _____ R _____ | NW Cor., Sec. 1 |
| | T _____ R _____ | |
| | T <u>7N</u> R <u>13W</u> | <u>K-13</u> |
| 2. Property Controlling in Section | S _____ T _____ R _____ | |
| | S _____ T _____ R _____ | |
| 3. Miscellaneous Property in Sec. | S _____ T _____ R _____ | |
| | S _____ T _____ R _____ | |
| 4. Lot No. _____, Recorded Plat _____ | | |
| 5. Private Claims _____ | | |

RECORDED
98 JUL 24 PM 1:46

James H. ...
REGISTER OF DEEDS
OTTAWA COUNTY, MI

Register of Deeds Stamp & File Number

I, Rodney D. Unema, in a field survey on May 21, 19 98, do hereby certify that under requirements of P.A. 74, Michigan P.A. of 1970, the corner points mentioned in lines 1 and 2 above were in conformance with regulations and rules therefore as required in the current manual of survey instructions of the United States Department of the Interior, Bureau of Land Management or by a decree of a Court of Law and/or that the corner points mentioned in lines 3, 4 and 5 above were in conformance with the rules of the Michigan Board of Land Surveyors or by a Decree of a Court of Law; established, re-established, monumented, re-monumented, recovered, found as expressed below:

| A | B | C | D | E | F | G | H | I | J | K | L | M |
|----|----|----|----|----|----|----|---|---|---|---|---|---|
| 2 | 6 | 5 | 4 | 3 | 2 | 1 | | | | | | |
| 3 | | | | | | | | | | | | |
| 4 | 7 | 8 | 9 | 10 | 11 | 12 | | | | | | |
| 5 | | | | | | | | | | | | |
| 6 | 18 | 17 | 16 | 15 | 14 | 13 | | | | | | |
| 7 | | | | | | | | | | | | |
| 8 | 19 | 20 | 21 | 22 | 23 | 24 | | | | | | |
| 9 | | | | | | | | | | | | |
| 10 | 30 | 29 | 28 | 27 | 26 | 25 | | | | | | |
| 11 | | | | | | | | | | | | |
| 12 | 31 | 32 | 33 | 34 | 35 | 36 | | | | | | |
| 13 | | | | | | | | | | | | |

NOTE: Not more than 4 corners, all in the same town and range, may be recorded on this certificate.

A. Description of original monument and accessories and/or subsequent restoration:

K-1
Corner not set by G.L.O.
From W & W witness map:
"T" Iron - 8" Elm East 11.3'
 - 8" Elm S 27.35'
 - 9" Ash SE 42.95'
Common corner with K-13, T7N, R13W

(OVER) *Over for sketch

B. Description of corner evidence found and/or method applied in restoring or reestablishing corner:

K-1
Found Steel Fence Post in swampy area
Found 6" Stump N90°E 23.0'
Found 10" Stump S0°E 43.3'

Corner is common with K-13, T7N, R13W

This position not established by original government surveyors. This monument is accepted as the best available evidence of the position of the corner.


PA. 345 OTTAWA COUNTY
PEER APPROVED 6-1-98

R. D. U.

C. Description of monument for corner and accessories established to perpetuate locating the position of the corner:

K-1
Steel Fence Post in swamp
Set nail & O.C. tag in N'y side 22" Willow S50°W 50.58'
Set nail & O.C. tag in N'y side 4" Oak S88°E 66.38'
Set nail & O.C. tag in W'y side Service Pole N5°W 159.20'
S 1/4 corner Sec. 36 East 2615.98'

Corner is common with K-13, T7N, R13W

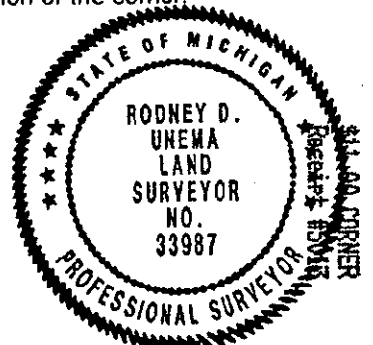

Signed by Rodney D. Unema Date May 29, 1998
Surveyor's Michigan License No. 33987

