

**SURVEY &  
REMONUMENTATION**

APR 24 1995

COMMISSION

OTTAWA COUNTY REMONUMENTATION

LAND CORNER RECORDATION CERTIFICATE  
Filing Requirement of Act 74, Mich. P.A. 1970

RECORDED

94 DEC 14 AM 9:39

*Richard D. Williams*  
REGISTER OF DEEDS  
OTTAWA COUNTY, MI

For corners in OTTAWA

(County)

Located In:

Corner Code #

- |                                       |   |    |   |     |   |
|---------------------------------------|---|----|---|-----|---|
| 1. Public Land Survey                 | T | 6N | R | 13W | K-6 (E 1/4 cor<br>of Sec 14)<br>Georgetown Twp. |
|                                       | T |    | R |     |   |
|                                       | T |    | R |     |   |
|                                       | T |    | R |     |   |
| 2. Property Controlling<br>in Section | S |    | T | R   |   |
|                                       | S |    | T | R   |   |
| 3. Miscellaneous<br>Property in Sec.  | S |    | T | R   |   |
|                                       | S |    | T | R   |   |

Register of Deeds Stamp & File Number

4. Lot No. \_\_\_\_\_, Recorded Plat \_\_\_\_\_  
5. Private Claims \_\_\_\_\_

I, Randal J. Vugteveen, in a field survey on November 30, 1994, do hereby certify that under requirements of P.A. 74, Michigan P.A. of 1970, the corner points mentioned in lines 1 and 2 above were in conformance with regulations and rules therefore as required in the current manual of survey instructions of the United States Department of the Interior, Bureau of Land Management or by a decree of a Court of Law and/or that the corner points mentioned in lines 3, 4 and 5 above were in conformance with the rules of the Michigan Board of Land Surveyors or by a Decree of a Court of Law; established, re-established, monumented, re-monumented, recovered, found as expressed below:

**NOTE: Not more than 4 corners, all in the same town and range, may be recorded on this certificate.**

	A	B	C	D	E	F	G	H	I	J	K	L	M
2	6		5		4		3		2		1		
3													
4	7		8		9		10		11		12		
5													
6	18		17		16		15		14	●	13		
7													
8	19		20		21		22		23		24		
9													
10	30		29		28		27		26		25		
11													
12	31		32		33		34		35		36		
13													

A. Description of original monument and accessories and/or subsequent restoration:  
K-6 common corner to Sections 13 & 14


- |                         |   |                           |
|-------------------------|---|---------------------------|
| 1831 - Lyon & Sibley    | Liber 1, Page 209 & 210                 | Liber 3, Page 252         |
| Set H.M.P.              | NE cor porch post @ ground S30°W 75.00' | PK in side PP SW 45.95'   |
| Beech 12" S34E 16 Links | SE cor hse fnd N40°W 90.37'             | Nail in face PP NW 44.20' |
| Pine 12" N34W 20 Links  | SW cor hse fnd N50°E 160.20'            | PK in side PP NE 56.72'   |

B. Description of corner evidence found and/or method applied in restoring or reestablishing corner:  
K-6 Found 1/2" rebar in mon box on centerline Baldwin between Melody & Sally Dr. and accepted as a careful and faithful perpetuation of the position of the original corner  
NE cor porch post @ ground S301/2W 74.95'

P.A. 345 OTTAWA COUNTY  
PEER APPROVED 12/12/94  
*Richard D. Williams*

C. Description of monument for corner and accessories established to perpetuate locating the position of the corner:  
Removed rebar, set 3/4" X 24" solid bar with Ottawa County Remon Cap in mon box

- AZ = Michigan State Grid Direction  
NE corner brick porch post house #808 at ground AZ. 200 deg 74.95'  
NW corner brick house #792 AZ. 163 deg 89.72'  
SW corner brick building #795 AZ. 34 deg 77.11'  
Set Ottawa County Remon Tag & Nail E side 24" Spruce AZ. 340 deg 91.28'

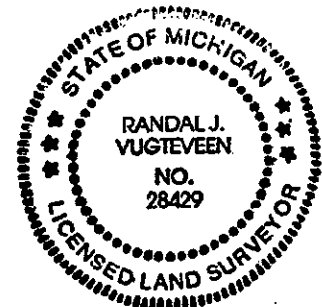

Signed by *Randal J. Vugteveen*

Date DEC 12, 1994

Surveyor's Michigan License No. 28429