

# SURVEY & REMONUMENTATION

APR 24 1995

OTTAWA COUNTY REMONUMENTATION

RECORDED

COMMISSION

LAND CORNER RECORDATION CERTIFICATE

94 DEC 14 AM 9:39

Filing Requirement of Act 74, Mich. P.A. 1970

*D. J. ...*  
REGISTER OF DEEDS  
OTTAWA COUNTY, MI

For corners in OTTAWA

(County)

Located In:

Corner Code #

1. Public Land Survey

T 6N R 13W K-7 (SE cor of  
Sec 14)  
Georgetown Twp.

2. Property Controlling in Section

S \_\_\_ T \_\_\_ R \_\_\_  
S \_\_\_ T \_\_\_ R \_\_\_

3. Miscellaneous Property in Sec.

S \_\_\_ T \_\_\_ R \_\_\_  
S \_\_\_ T \_\_\_ R \_\_\_

Register of Deeds Stamp & File Number

4. Lot No. \_\_\_\_\_, Recorded Plat \_\_\_\_\_

5. Private Claims \_\_\_\_\_

	A	B	C	D	E	F	G	H	I	J	K	L	M
2	6		5		4		3		2		1		
3													
4	7		8		9		10		11		12		
5													
6	18		17		16		15		14		13		
7													
8	19		20		21		22		23		24		
9													
10	30		29		28		27		26		25		
11													
12	31		32		33		34		35		36		
13													

I, Randal J. Vugteveen, in a field survey on December 2, 1994

do hereby certify that under requirements of P.A. 74, Michigan P.A. of 1970, the corner points mentioned in lines 1 and 2 above were in conformance with regulations and rules therefore as required in the current manual of survey instructions of the United States Department of the Interior, Bureau of Land Management or by a decree of a Court of Law and/or that the corner points mentioned in lines 3, 4 and 5 above were in conformance with the rules of the Michigan Board of Land Surveyors or by a Decree of a Court of Law; established, re-established, monumented, re-monumented, recovered, found as expressed below:

**NOTE: Not more than 4 corners, all in the same town and range, may be recorded on this certificate.**

A. Description of original monument and accessories and/or subsequent restoration:  
K-7 common corner to Sections 13, 14, 23 & 24

1831 - Lyon & Sibley	Liber 3, Page 140
Set post	Nail in side of Power Pole SE 67.23' /
Beech 16" S34W 20 Links	Nail in side of Power Pole ENE 27.75' /
Do 10" N74E 30 Links	Nail in side Quad Maple NNE 73.25'

B. Description of corner evidence found and/or method applied in restoring or reestablishing corner:  
K-7 Found conc mon 2' SW of corner of 4' chain link fence N & E, 43' N of centerline RR tracks and accepted as a careful and faithful perpetuation of the position of the original corner


Nail in side Quad Maple NNE 73.23'

P.A. 345 OTTAWA COUNTY  
PEER APPROVED 12/12/94  
*Murray D. Nedeweld*

C. Description of monument for corner and accessories established to perpetuate locating the position of the corner:  
K-7 Removed concrete mon, set 3/4" X 36" solid bar with Ottawa County Remon Cap

AZ = Michigan State Grid Direction

Set Ottawa County Remon Tag & Nail in W side Quad Maple AZ. 5 deg 73.28'  
Face of 1 1/2" chain link fence post AZ. 32 deg 1.82'  
Set Ottawa County Remon Tag & Nail in N side P. pole AZ. 68 deg 28.22'  
Set Ottawa County Remon Tag & Nail in RR tie centerline tracks AZ. 153 deg 42.94'  
Set Ottawa County Remon Tag & Nail in W side P. pole AZ. 145 deg 67.20'  
Centerline NE pipe supporting billboard "Adams" AZ. 252 deg 111.38'

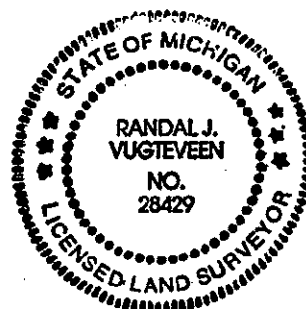

Signed by *Randal J. Vugteveen*  
Surveyor's Michigan License No. 28429

Date Dec 9, 1994