

SURVEY & REMONUMENTATION

APR 24 1995

COMMISSION

or corners in OTTAWA

OTTAWA COUNTY REMONUMENTATION

LAND CORNER RECORDATION CERTIFICATE

Filing Requirement of Act 74, Mich. P.A. 1970

RECORDED

94 DEC 14 AM 9:39

Robert J. Chubb
REGISTER OF DEEDS
OTTAWA COUNTY, MI

(County)	Located In:	Corner Code #
Public Land Survey	T <u>6N</u> R <u>13W</u>	K-9 (NE cor Section 26) Georgetown Twp.
Property Controlling in Section	S _____ T _____ R _____	_____
Miscellaneous	S _____ T _____ R _____	_____
Property in Sec.	S _____ T _____ R _____	_____

Register of Deeds Stamp & File Number

Lot No. _____, Recorded Plat _____
Private Claims _____

	A	B	C	D	E	F	G	H	I	J	K	L	M
2	6	5	4	3	2	1							
3													
4	7	8	9	10	11	12							
5													
6	18	17	16	15	14	13							
7													
8	19	20	21	22	23	24							
9													
10	30	29	28	27	26	25							
11													
12	31	32	33	34	35	36							
13													

Randal J. Vugteveen, in a field survey on December 6, 1994,
do hereby certify that under requirements of P.A. 74, Michigan P.A. of 1970, the corner points mentioned in lines 1 and 2 above were in conformance with regulations and rules therefore as required in the current manual of survey instructions of the United States Department of the Interior, Bureau of Land Management or by a decree of a Court of Law and/or that the corner points mentioned in lines 3, 4 and 5 above were in conformance with the rules of the Michigan Board of Land Surveyors or by a Decree of a Court of Law; established, re-established, monumented, re-monumented, recovered, found as expressed below:

NOTE: Not more than 4 corners, all in the same town and range, may be recorded on this certificate.

1. Description of original monument and accessories and/or subsequent restoration:
K-9 Common corner to Sections 23, 24, 25 & 26

1831 - Lyon & Sibley	Liber 2, Page 435	Liber 3, Page 358
Set post	1/2" Iron	Iron
Ash 14" S10E 4 Links	PK in side T. pole SE 47.85'	PK in side T. pole SE 47.88'
Lynn 7" N57W 38 Links	SW cor of garage NE 73.33'	SW corner garage NE 79.23'
	SE cor hse #6405 NW 86.85'	SE corner House #6405 NW 86.85'

2. Description of corner evidence found and/or method applied in restoring or reestablishing corner:
K-9 Found capped iron on centerline 8th Avenue in mon box and accepted as a careful and faithful perpetuation of the position of the original corner

SE corner of house #6405 NW 86.85'	SE corner House #6405 NW 86.85'	Nail in W side P. pole S20W 83.80
		PK nail SW side T. pole S55E 47.95'
		SW cor frame garage N50E 79.11'
		NW cor conc fnd to hse #6382 AZ 133 101.62'
		SE cor brick hse #6405 N65W 86.65'
		SE cor brick hse #6389 AZ 232 101.89'


P.A. 345 OTTAWA COUNTY

PEER APPROVED

12/12/94

3. Description of monument for corner and accessories established to perpetuate location and position of the corner:
K-9 Removed iron, set 3/4" X 24' solid rod with Ottawa County Remon cap

AZ = Michigan State Grid Direction
SW corner siding garage, house #6400 AZ. 51 deg 79.11'
NW foundation corner house #6382 AZ. 133 deg 101.62'
SE corner brick house #6405 AZ. 293 deg 86.65'
SE corner brick house #6389 AZ. 232 deg 101.89'

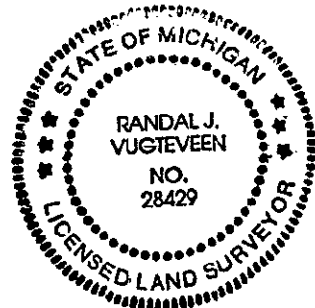

Signed by *Randal J. Vugteveen*

Date Dec 12, 1994

Surveyor's Michigan License No. 28429