

# SURVEY & REMONUMENTATION

OCT 07 1996

OTTAWA COUNTY REMONUMENTATION

COMMISSION

LAND CORNER RECORDATION CERTIFICATE

Filing Requirement of Act 74, Mich. P.A. 1970

For corners in OTTAWA

(County)

Located in:

Corner Code #

- |                                    |   |           |   |            |  |
|------------------------------------|---|-----------|---|------------|--|
| 1. Public Land Survey              | T | <u>6N</u> | R | <u>13W</u> | K-11 (SE cor<br>Section 26)<br>Georgetown Twp. |
|                                    | T |           | R |            |  |
|                                    | T |           | R |            |  |
|                                    | T |           | R |            |  |
|                                    | T |           | R |            |  |
| 2. Property Controlling in Section | S |           | T | R          |  |
|                                    | S |           | T | R          |  |
| 3. Miscellaneous Property in Sec.  | S |           | T | R          |  |
|                                    | S |           | T | R          |  |
4. Lot No. \_\_\_\_\_, Recorded Plat \_\_\_\_\_
5. Private Claims \_\_\_\_\_

RECORDED

96 AUG 26 PM 2:02

*Randy J. Vugteveen*  
REGISTER OF DEEDS  
OTTAWA COUNTY, MI

Register of Deeds Stamp & File Number

	A	B	C	D	E	F	G	H	I	J	K	L	M
2	6		5		4		3		2		1		
3													
4	7		8		9		10		11		12		
5													
6	18		17		16		15		14		13		
7													
8	19		20		21		22		23		24		
9													
10	30		29		28		27		26		25		
11													
12	31		32		33		34		35		36		
13													

I, Randal J. Vugteveen, in a field survey on December 12, 1995, do hereby certify that under requirements of P.A. 74, Michigan P.A. of 1970, the corner points mentioned in lines 1 and 2 above were in conformance with regulations and rules therefore as required in the current manual of survey instructions of the United States Department of the Interior, Bureau of Land Management or by a decree of a Court of Law and/or that the corner points mentioned in lines 3, 4 and 5 above were in conformance with the rules of the Michigan Board of Land Surveyors or by a Decree of a Court of Law; established, re-established, monumented, re-monumented, recovered, found as expressed below:

**NOTE: Not more than 4 corners, all in the same town and range, may be recorded on this certificate.**

A. Description of original monument and accessories and/or subsequent restoration:  
K-11 Common corner to Sections 25, 26, 35 & 36

1831 - Lyon & Sibley	Liber 1, Page 335
Set post	MSHD tag in side of P. pole W 60.49'
Beech 7" N421/2E 6 Links	Nail in side of P. pole E 40.03'
Sugar 6" S51W 32 Links	NW corner of hse ESE 75.47'
	SW corner of hse SE 118.08'
	Centerline of road W 1.0'

B. Description of corner evidence found and/or method applied in restoring or reestablishing corner:  
K-11 Found PK nail 1' East of centerline 8th Avenue and accepted as a careful and faithful perpetuation of the position of the original corner


Nail in side of P. pole E 39.95'
NW corner of brick hse #5590 AZ 113 75.44'
SW corner of hse AZ 145 118.15'
Centerline of road W 1.0'

P.A. 345 OTTAWA COUNTY  
PEER APPROVED 12/11/95

*Randy J. Vugteveen*

C. Description of monument for corner and accessories established to perpetuate locating the position of the corner:  
K-11 Found boat spike below PK, removed and set 3/4" x 24" with Ottawa County Remon Cap in mon box

Set Ottawa County Tag & Nail in NW side Twin 8" Oak Willow AZ 217 62.96'
Set Ottawa County Tag & Nail in N side P. pole AZ 265 60.75'
Set Ottawa County Tag & Nail in N side P. pole AZ 85 39.95'
NW corner brick house #5590 AZ 113 75.44'
SW corner brick house #5590 AZ 145 118.15'

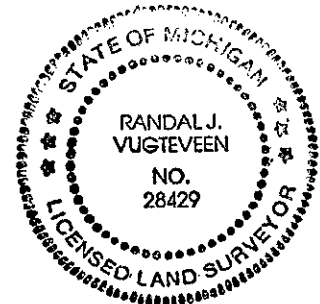

Signed by *Randal J. Vugteveen*  
Surveyor's Michigan License No. 28429

Date Dec 11, 1995