

SURVEY & REMONUMENTATION

APR 05 1996

OTTAWA COUNTY REMONUMENTATION

COMMISSION

LAND CORNER RECORDATION CERTIFICATE

Filing Requirement of Act 74, Mich. P.A. 1970

For corners in OTTAWA  
(County)

Located In:

Corner Code #

- |                                       |                           |   |
|---------------------------------------|---------------------------|---|
| 1. Public Land Survey                 | T <u>6N</u> R <u>R13W</u> | K-13 (SE corner<br>Section 35)<br>Georgetown Twp. |
|                                       | T _____ R _____           |   |
|                                       | T _____ R _____           |   |
|                                       | T _____ R _____           |   |
| 2. Property Controlling<br>in Section | S _____ T _____ R _____   |   |
|                                       | S _____ T _____ R _____   |   |
| 3. Miscellaneous<br>Property in Sec.  | S _____ T _____ R _____   |   |
|                                       | S _____ T _____ R _____   |   |

RECORDED

95 NOV 15 PM 2: 10

*D. J. Vugteveen*  
REGISTER OF DEEDS  
OTTAWA COUNTY, MI

Register of Deeds Stamp & File Number

4. Lot No. \_\_\_\_\_, Recorded Plat \_\_\_\_\_  
5. Private Claims \_\_\_\_\_

I, Randal J. Vugteveen, in a field survey on October 19, 19 95, do hereby certify that under requirements of P.A. 74, Michigan P.A. of 1970, the corner points mentioned in lines 1 and 2 above were in conformance with regulations and rules therefore as required in the current manual of survey instructions of the United States Department of the Interior, Bureau of Land Management or by a decree of a Court of Law and/or that the corner points mentioned in lines 3, 4 and 5 above were in conformance with the rules of the Michigan Board of Land Surveyors or by a Decree of a Court of Law; established, re-established, monumented, re-monumented, recovered, found as expressed below:

**NOTE: Not more than 4 corners, all in the same town and range, may be recorded on this certificate.**

	A	B	C	D	E	F	G	H	I	J	K	L	M
2	6		5		4		3		2		1		
3													
4	7		8		9		10		11		12		
5													
6	18		17		16		15		14		13		
7													
8	19		20		21		22		23		24		
9													
10	30		29		28		27		26		25		
11													
12	31		32		33		34		35		36		
13													

A. Description of original monument and accessories and/or subsequent restoration:

K-13 Common corner to Sections 35 & 36

- |                           |                             |   |
|---------------------------|-----------------------------|---|
| 1831 - Sibley             | Liber 5, page 256           | Liber 3, Page 7                         |
| Set post                  | Set CIM                     | Nail in T pole S 22.27'                 |
| Lynn N48 E25 20 Links     | 18" Maple NW 105.44'        | Nail in T pole WSW 104.8'               |
| Sugar N34 1/2 W17 6 Links | TP SW 107.13'               | Nail in 16" Maple WNW 80.75'            |
|                           | center of St. sign S 28.37' | Center of street marker post SSW 27.91' |
|                           | 8" Elm SE 51.72'            | Nail in 14" Walnut NE 31.42'            |

B. Description of corner evidence found and/or method applied in restoring or reestablishing corner:

K-13 Found CIM in mon box 25' E of centerline "X" 8th Ave & Jackson St. and accepted as a careful and faithful perpetuation of the position of the original corner

- Found CIM  
T. pole Az. 215 deg 107.09'  
Center of St. sign S 28.49'


EA 345 OTTAWA COUNTY  
PEER APPROVED 10/23/95

*[Signatures]*

C. Description of monument for corner and accessories established to perpetuate locating the position of the corner:

K-13 Cast Iron Mon

- 3/4" dia. in mon box (Jamestown corner) Az. 270 deg 28.63'  
NW foundation corner garage #790 Jackson Az. 151 deg 109.22'  
Set Ottawa County Remon Nail & Tag below Joiner Nail & Tag in SE side p. pole Az. 215 deg 107.13'  
Set Ottawa County Remon Nail & Tag in SW side 18" Maple Az. 319 deg 105.42'  
SW corner brick garage #4824 8th Ave Az. 43 deg 156.34'  
SE foundation corner garage #825 Jackson Az. 296 deg 212.69'

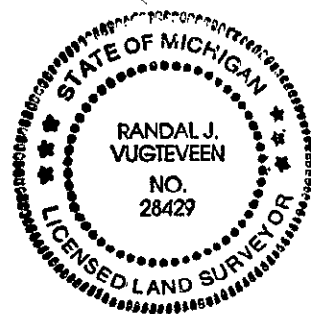

Signed by *[Signature]*  
Surveyor's Michigan License No. 28429

Date Oct. 20, 1995

FORM APPROVED BY MICHIGAN STATE BOARD OF LAND SURVEYORS, JAN. 28, '91  
REVISED MAY 14, '91  
REVISED JAN. '91