

SURVEY & REMONUMENTATION

DEC 01 1998

SECTION

**OTTAWA COUNTY REMONUMENTATION
LAND CORNER RECORDATION CERTIFICATE
Filing Requirement of Act 74, Mich. P.A. 1970**

For corners in

<u>Ottawa</u> <small>(County)</small>	Located In: Tallmadge Township	Corner Code #: <u>L-1</u> N 1/4 corner Sec. 1 <u>L-13</u>
1. Public Land Survey	T <u>6N</u> R <u>13W</u>	
	T _____ R _____	
	T _____ R _____	
	T <u>7N</u> R <u>13W</u>	
2. Property Controlling in Section	S _____ T _____ R _____	
	S _____ T _____ R _____	
3. Miscellaneous Property in Sec.	S _____ T _____ R _____	
	S _____ T _____ R _____	

RECORDED
98 JUL 24 PM 1:46

Gary Hubbert
REGISTER OF DEEDS
OTTAWA COUNTY, MI

Register of Deeds Stamp & File Number

4. Lot No. _____, Recorded Plat _____
5. Private Claims _____

A	B	C	D	E	F	G	H	I	J	K	L	M
2	6	5	4	3	2	1						
3												
4	7	8	9	10	11	12						
5												
6	18	17	16	15	14	13						
7												
8	19	20	21	22	23	24						
9												
10	30	29	28	27	26	25						
11												
12	31	32	33	34	35	36						
13												

I, Rodney D. Unema, in a field survey on May 21, 19 98, do hereby certify that under requirements of P.A. 74, Michigan P.A. of 1970, the corner points mentioned in lines 1 and 2 above were in conformance with regulations and rules therefore as required in the current manual of survey instructions of the United States Department of the Interior, Bureau of Land Management or by a decree of a Court of Law and/or that the corner points mentioned in lines 3, 4 and 5 above were in conformance with the rules of the Michigan Board of Land Surveyors or by a Decree of a Court of Law; established, re-established, monumented, re-monumented, recovered, found as expressed below:

NOTE: Not more than 4 corners, all in the same town and range, may be recorded on this certificate.

A. Description of original monument and accessories and/or subsequent restoration:

L-1 Corner not set by G.L.O.	No recorded L.C.R.C. Witnesses; From Ottawa Co. Road Comm. witness map: Iron @ 2652 W. of NE cor., Sec. 1 Fence E & W Fence N 103' W Fence S 285' E 8" Hickory WSW 16.4' 18" Double Oak W 4'
------------------------------------	---

*Over for sketch

B. Description of corner evidence found and/or method applied in restoring or reestablishing corner:


L-1
Found 1/2" Iron Pipe on E-W tree ROW and old fence line
18" Hickory N70°W 16.3'
Double 24" Oak West + 4' to approx. ♂
Corner is common with L-13, T7N, R13W
This position not established by original government surveyors.
This monument is accepted as the best available evidence of the position of the corner.
Replaced 1/2" Iron with 3/4" X 36" steel bar and standard Ottawa Co. Cap

RECORDED
7-20-98
R.D.U.

C. Description of monument for corner and accessories established to perpetuate locating the position of the corner:

L-1 Corner is on old fence line running E & W and E-W tree ROW Set nail & O.C. tag in N side 10" Maple Set nail & O.C. tag in N side 18" Hickory Set nail & O.C. tag in SE side 24" Double Oak	S80°E 7.20' N70°W 16.28' West 5.68'
--	---

Corner is common with L-13, T7N, R13W

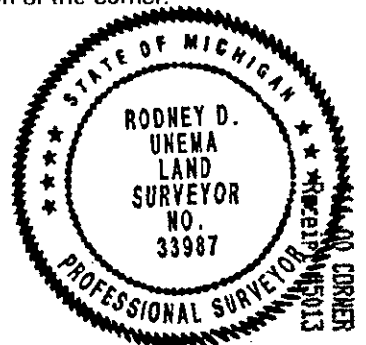

Signed by *Rodney D. Unema* Date May 29, 1998
Surveyor's Michigan License No. 33987

