

SURVEY & REMONUMENTATION

APR 24 1995

OTTAWA COUNTY REMONUMENTATION

RECORDED

COMMISSION

LAND CORNER RECORDATION CERTIFICATE

96 DEC 14 AM 9:40

Filing Requirement of Act 74, Mich. P.A. 1970

For corners in OTTAWA

Dorothy C. ...
REGISTER OF DEEDS
OTTAWA COUNTY, MI

(County)	Located In:	Corner Code #
1. Public Land Survey	T <u>6N</u> R <u>13W</u>	L-7 (S 1/4 COR of Sec 13) Georgetown Twp.
	T _____ R _____	
	T _____ R _____	
	T _____ R _____	
2. Property Controlling in Section	S _____ T _____ R _____	
	S _____ T _____ R _____	
3. Miscellaneous Property in Sec.	S _____ T _____ R _____	
	S _____ T _____ R _____	
4. Lot No. _____, Recorded Plat _____		
5. Private Claims _____		

Register of Deeds Stamp & File Number

	A	B	C	D	E	F	G	H	I	J	K	L	M
2	6	5	4	3	2	1							
3													
4	7	8	9	10	11	12							
5													
6	18	17	16	15	14	13							
7													
8	19	20	21	22	23	24							
9													
10	30	29	28	27	26	25							
11													
12	31	32	33	34	35	36							
13													

I, Randal J. Vugteveen, in a field survey on December 2, 1994, do hereby certify that under requirements of P.A. 74, Michigan P.A. of 1970, the corner points mentioned in lines 1 and 2 above were in conformance with regulations and rules therefore as required in the current manual of survey instructions of the United States Department of the Interior, Bureau of Land Management or by a decree of a Court of Law and/or that the corner points mentioned in lines 3, 4 and 5 above were in conformance with the rules of the Michigan Board of Land Surveyors or by a Decree of a Court of Law; established, re-established, monumented, re-monumented, recovered, found as expressed below:

NOTE: Not more than 4 corners, all in the same town and range, may be recorded on this certificate.

A. Description of original monument and accessories and/or subsequent restoration:
L-7 common corner to Sections 13 & 24

1831 - Lyon & Sibley	Liber 5, Page 195
Set 1/4 Section post	Nail & BC in N side 24" Maple E 157.68' /
W. Oak 16" N4W 28 Links	Ely edge of 22' gravel drive WNW 184' /
Do 15" S35W 47 Links	250 yard marker on driving range NNW 191' /
	Iron stake at prop. corner N10 1/2 E 351.80'

B. Description of corner evidence found and/or method applied in restoring or reestablishing corner:
L-7 Found Exxel cap in open field behind driving range and accepted as a careful and faithful perpetuation of the position of the original corner


Nail & BC in N side 24" Maple E 157.67'
250 yard marker on driving range NNW 191'

P.A. 1345 OTTAWA COUNTY
PEER APPROVED 12/12/94

Murray D. Nedwell

C. Description of monument for corner and accessories established to perpetuate locating the position of the corner:
L-7 Removed iron, set 3/4" X 36" solid bar with Ottawa County Remon Cap

AZ = Michigan State Grid Direction
Set Ottawa County Remon Tag & Nail in N side 30" Maple AZ. 90 deg. 157.67'
Set Ottawa County Remon Tag & Nail in W side Twin 12" Elm AZ. 346 deg 267.48'
SW corner Blue Block Post Office AZ. 0 deg 756.76'
SW corner Target Store AZ. 37 deg 608.59'

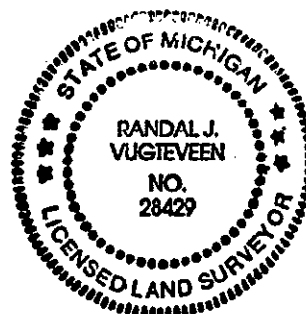

Signed by *Randal J. Vugteveen*
Surveyor's Michigan License No. 28429

Date Dec 9, 1994