

SURVEY & REMONUMENTATION

APR 24 1995

COMMISSION

For corners in OTTAWA

OTTAWA COUNTY REMONUMENTATION

LAND CORNER RECORDATION CERTIFICATE

Filing Requirement of Act 74, Mich. P.A. 1970

RECORDED

94 DEC 14 AM 9:40

Register of Deeds
REGISTER OF DEEDS
OTTAWA COUNTY, MI

(County)	Located In:	Corner Code #
1. Public Land Survey	T <u>6N</u> R <u>13W</u>	L-9 (S 1/4 cor of Sec 24) Georgetown Twp.
	T _____ R _____	_____
	T _____ R _____	_____
	T _____ R _____	_____
2. Property Controlling in Section	S _____ T _____ R _____	_____
	S _____ T _____ R _____	_____
3. Miscellaneous Property in Sec.	S _____ T _____ R _____	_____
	S _____ T _____ R _____	_____

Register of Deeds Stamp & File Number

4. Lot No. _____, Recorded Plat _____
5. Private Claims _____

	A	B	C	D	E	F	G	H	I	J	K	L	M
2	6	5	4	3	2	1							
3													
4	7	8	9	10	11	12							
5													
6	18	17	16	15	14	13							
7													
8	19	20	21	22	23	24							
9													
10	30	29	28	27	26	25							
11													
12	31	32	33	34	35	36							
13													

Randal J. Vugteveen, in a field survey on November 29, 1994, to hereby certify that under requirements of P.A. 74, Michigan P.A. of 1970, the corner points mentioned in lines 1 and 2 above were in conformance with regulations and rules therefore as required in the current manual of survey instructions of the United States Department of the Interior, Bureau of Land Management or by a decree of a Court of Law and/or that the corner points mentioned in lines 3, 4 and 5 above were in conformance with the rules of the Michigan Board of Land Surveyors or by a Decree of a Court of Law; established, re-established, monumented, re-monumented, recovered, found as expressed below:

NOTE: Not more than 4 corners, all in the same town and range, may be recorded on this certificate.

A. Description of original monument and accessories and/or subsequent restoration:
L-9 common corner to Sections 24 & 25

1831 - Lyon & Sibley	Liber 3, Page 156
Set 1/4 Section post	24" Ash N 139.77'
Lynn 7" N44E 42 Links	4" Maple N 19.00'
Lynn 10" N46W 18 Links	P. Pole S 132.80'
	16" Ash NE 90.29'

3. Description of corner evidence found and/or method applied in restoring or reestablishing corner:
L-9 Found CIM 78' West of creek bank 200' N of golf cart bridge and accepted as a careful and faithful perpetuation of the position of the original corner


30" Ash 139.6' to face
4" Maple N 19.2'
P. Pole N side 132.80'

P.A. 345 OTTAWA COUNTY
PEER APPROVED 12/12/94

Murray P. Nedeweld

C. Description of monument for corner and accessories established to perpetuate locating the position of the corner:
L-9 Cast Iron Monument

AZ = Michigan State Grid Direction
Set Ottawa County Remon Tag & Nail in SE side 14" Maple AZ. 200 deg 31.74'
Set Ottawa County Remon Tag & Nail in W side of 14" Maple AZ. 5 deg 19.26'
Set Ottawa County Remon Tag & Nail in W side of 24" Ash AZ. 45 deg 90.82'
Set Ottawa County Remon Tag & Nail in W side P. pole AZ. 180 deg 133.20'

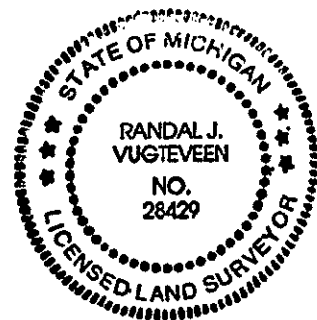

Signed by Randal J. Vugteveen
Surveyor's Michigan License No. 28429

Date Dec 12, 1994