

SURVEY & REMONUMENTATION

APR 24 1995

COMMISSION

For corners in OTTAWA

OTTAWA COUNTY REMONUMENTATION

LAND CORNER RECORDATION CERTIFICATE
Filing Requirement of Act 74, Mich. P.A. 1970

RECORDED

94 DEC 14 AM 9:43

Phyllis Robinson
REGISTER OF DEEDS
OTTAWA COUNTY, MI

Located In: Corner Code #

1. Public Land Survey	T	6N	R	13W	L-11 (S 1/4 cor Section 25) Georgetown Twp.
	T		R		
	T		R		
	T		R		
2. Property Controlling in Section	S		T	R	
	S		T	R	
3. Miscellaneous Property in Sec.	S		T	R	
	S		T	R	

Register of Deeds Stamp & File Number

4. Lot No. _____, Recorded Plat _____
5. Private Claims _____

	A	B	C	D	E	F	G	H	I	J	K	L	M
2	6		5		4		3		2		1		
3													
4	7		8		9		10		11		12		
5													
6	18		17		16		15		14		13		
7													
8	19		20		21		22		23		24		
9													
10	30		29		28		27		26		25		
11													
12	31		32		33		34		35		36		
13													

I, Randal J. Vugteveen, in a field survey on December 6, 1994, do hereby certify that under requirements of P.A. 74, Michigan P.A. of 1970, the corner points mentioned in lines 1 and 2 above were in conformance with regulations and rules therefore as required in the current manual of survey instructions of the United States Department of the Interior, Bureau of Land Management or by a decree of a Court of Law and/or that the corner points mentioned in lines 3, 4 and 5 above were in conformance with the rules of the Michigan Board of Land Surveyors or by a Decree of a Court of Law; established, re-established, monumented, re-monumented, recovered, found as expressed below:

NOTE: Not more than 4 corners, all in the same town and range, may be recorded on this certificate.

A. Description of original monument and accessories and/or subsequent restoration:
L-11 Common corner to Sections 25 & 36

1831 - Lyon & Sibley	Liber 4, Page 213
Set 1/4 Section post	1/2" solid rod
Sugar 12" N23E 15 Links	Edge concrete pavement SE 26.20'
Do 10" S5W 15 Links	Fence corner North 82.10'
	"X" in Sta 1186+00 stpd on pvmt ESE 31.16'
	"X" in Sta 1185+00 stpd on pvmt SSW 89.98'

B. Description of corner evidence found and/or method applied in restoring or reestablishing corner:
L-11 Found 1/2" solid bar 26' NW of edge concrete to W bound I-196 & 289' NE of Mile 66 marker sign and accepted as a careful and faithful perpetuation of the position of the original corner

Edge concrete pavement SE 26.14' / Fence corner North 82.16' / "X" in Sta 1186+00 stpd on pvmt AZ. 112 deg 31.21' / "X" in Sta 1185+00 stpd on pvmt AZ. 212 deg 89.90'
--


P.A. 345 OTTAWA COUNTY
PEER APPROVED 12/12/94

Rodney D. Nedwell

C. Description of monument for corner and accessories established to perpetuate locating the position of the corner:
L-11 Removed 1/2" bar, set 3/4" X 36" solid bar with Ottawa County Remon Cap

AZ = Michigan State Grid Direction

Mile 66 marker AZ. 229 deg 289.00'
Concrete monument AZ. 0 deg 84.08'
Set Ottawa County Remon Tag & Nail in N side 3" Ash AZ. 318 deg 29.94'
"X" in Sta. 1186+00 stamped on pavement AZ. 112 deg 31.21'

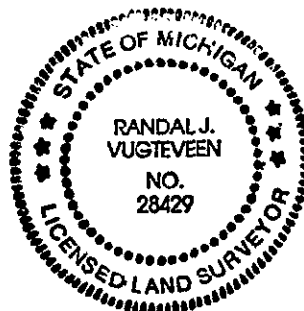

Signed by Randal J. Vugteveen

Date DEC 9, 1994

Surveyor's Michigan License No. 28429