

OTTAWA COUNTY REMONUMENTATION

APR 05 1996

COMMISSION

LAND CORNER RECORDATION CERTIFICATE
Filing Requirement of Act 74, Mich. P.A. 1970

For corners in
OTTAWA
(County)

	Located In:	Corner Code #
1. Public Land Survey	T6N R13W	L-13 (S 1/4 cor Section 36) Georgetown Twp.
	T ___ R ___	
	T ___ R ___	
	T ___ R ___	
2. Property Controlling in Section	S ___ T ___ R ___	
	S ___ T ___ R ___	
3. Miscellaneous Property in Sec.	S ___ T ___ R ___	
	S ___ T ___ R ___	

RECORDED

95 NOV 15 PM 2: 10

Phyllis Callman
REGISTER OF DEEDS
OTTAWA COUNTY, MI

Register of Deeds Stamp & File Number

- 4. Lot No. _____, Recorded Plat _____
- 5. Private Claims _____

	A	B	C	D	E	F	G	H	I	J	K	L	M
2	6	5	4	3	2	1							
3													
4	7	6	5	4	3	2	1						
5													
6	8	7	6	5	4	3	2	1					
7													
8	9	8	7	6	5	4	3	2	1				
9													
10	10	9	8	7	6	5	4	3	2	1			
11													
12	11	10	9	8	7	6	5	4	3	2	1		
13													

I, Randal J. Vugteveen, in a field survey on October 18, 19 95, do hereby certify that under requirements of P.A. 74, Michigan P.A. of 1970, the corner points mentioned in lines 1 and 2 above were in conformance with regulations and rules therefore as required in the current manual of survey instructions of the United States Department of the Interior, Bureau of Land Management or by a decree of a Court of Law and/or that the corner points mentioned in lines 3, 4 and 5 above were in conformance with the rules of the Michigan Board of Land Surveyors or by a Decree of a Court of Law; established, re-established, monumented, re-monumented, recovered, found as expressed below:

NOTE: Not more than 4 corners, all in the same town and range, may be recorded on this certificate.

A. Description of original monument and accessories and/or subsequent restoration:
L-13 Common corner to Section 36

1831 - sibley	Liber 3, Page 187
Set HMP	Replace boat spike over "T" iron with CIM
Beech N72 1/2 E45 8 Links	/ inscribed "Ottawa County Section Corner"
Sugar N60 W10 5 Links	/ 14" Walnut SE 40.54' / NW cor brick hse SE 82.76'
	Center St. sign S 22.8' / PP SW 30.07'
	PP SW 28.88' / N 1/4 corner Section 1, Jamestown Twp, W 14.12'

B. Description of corner evidence found and/or method applied in restoring or reestablishing corner:


L-13 Found 3/4" dia. pipe in mon box 1.3' N of centerline "X" Jackson St. & 4th Ave North and accepted as a careful and faithful perpetuation of the position of the original corner
Nail in SW side 14" Walnut SE 40.50'
NW corner brick hse SE 82.68'
N 1/4 corner Section 1, Jamestown Twp, W 14.02'

PEER APPROVED 10/23/95

Goof Medoy D. Medwood

C. Description of monument for corner and accessories established to perpetuate locating the position of the corner:

L-13 Removed 3/4" iron, set 3/4" X 24" solid bar with Ottawa County Remon cap in mon box
NW corner brick house #0390 Az. 153 deg 82.68'
Set Ottawa County Remon Nail & Tag in E side p. pole Az. 203 deg 33.69'
NE corner block foundation house #410 Az. 224 deg 88.54'
Set Ottawa County Remon Nail & Tag in S side p. pole Az. 284 deg 120.79'
Nail in mon box Jamestown corner Az. 270 deg 14.04'

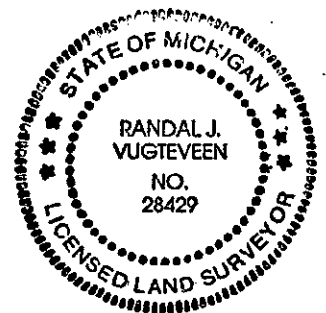

Signed by *Randal J. Vugteveen*

Date Oct 20, 1995

Surveyor's Michigan License No. 28429