

SURVEY & REMONUMENTATION

OCT 07 1996

OTTAWA COUNTY REMONUMENTATION

COMMISSION

LAND CORNER RECORDATION CERTIFICATE

Filing Requirement of Act 74, Mich. P.A. 1970

For corners in OTTAWA

(County)	Located In:	Corner Code #	
	6N 13W	M-4 (E 1/4 cor	
1. Public Land Survey	T _____ R _____	Section 12)	
	T _____ R _____	Georgetown Twp.	
	T _____ R _____		
	T _____ R _____		
2. Property Controlling in Section	S _____ T _____ R _____		
	S _____ T _____ R _____		
3. Miscellaneous Property in Sec.	S _____ T _____ R _____		
	S _____ T _____ R _____		
4. Lot No. _____, Recorded Plat _____			
5. Private Claims _____			

RECORDED

96 AUG 26 PM 2:01

Randy J. Vugteveen
REGISTER OF DEEDS
OTTAWA COUNTY, MI

Register of Deeds Stamp & File Number

I, Randal J. Vugteveen, in a field survey on January 4, 1996, do hereby certify that under requirements of P.A. 74, Michigan P.A. of 1970, the corner points mentioned in lines 1 and 2 above were in conformance with regulations and rules therefore as required in the current manual of survey instructions of the United States Department of the Interior, Bureau of Land Management or by a decree of a Court of Law and/or that the corner points mentioned in lines 3, 4 and 5 above were in conformance with the rules of the Michigan Board of Land Surveyors or by a Decree of a Court of Law; established, re-established, monumented, re-monumented, recovered, found as expressed below:

NOTE: Not more than 4 corners, all in the same town and range, may be recorded on this certificate.

	A	B	C	D	E	F	G	H	I	J	K	L	M
2	8	5	4	3	2	1							
3													
4	7	8	9	10	11	12							
5													
6	18	17	16	15	14	13							
7													
8	19	20	21	22	23	24							
9													
10	30	29	28	27	26	25							
11													
12	31	32	33	34	35	36							
13													

A. Description of original monument and accessories and/or subsequent restoration:

M-4 Common corner to Section 7-6-12
1831 - Sibley
Set 1/4 Sec. post
Beech 8 N 77W 40
B. Ash 11 S 59W 27

NO RECORDED INFORMATION

B. Description of corner evidence found and/or method applied in restoring or reestablishing corner:

Found KCRM on centerline Kenowa and accepted as a careful and faithful perpetuation of the position of the original corner


P.A. 345 OTTAWA COUNTY
PEER APPROVED 5-20-96

Randy J. Vugteveen

Held as common corner per Kent County witness map, Gov't Suvey Map and Survey Records

C. Description of monument for corner and accessories established to perpetuate locating the position of the corner:

M-4 Kent County Harrison Monument
Set Ottawa County Remon Nail & Tag above KCRM nail & Tag in NE side Twin 12" Ash Az. 159 deg 59.27'
Set Ottawa County Remon Nail & Tag above KCRM nail & tag in NW side 10" Ash Az. 235 deg 43.74'
Set Ottawa County Remon Nail & Tag above KCRM nail & tag in SW side 10" Ash Az. 326 deg 81.98'
Set Ottawa County Remon Nail & Tag above KCRM nail & tag in NW side 10" Ash Az. 44 deg 62.82'

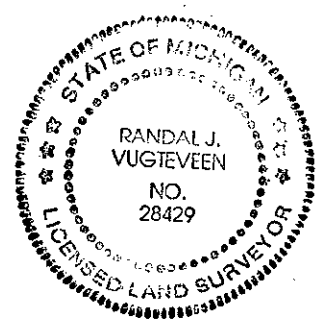

Signed by *Randal J. Vugteveen*
Surveyor's Michigan License No. 28429

Date MAY 20, 1996