

SURVEY & REMONUMENTATION

APR 24 1995

OTTAWA COUNTY REMONUMENTATION

RECORDED

COMMISSION

LAND CORNER RECORDATION CERTIFICATE
Filing Requirement of Act 74, Mich. P.A. 1970

94 DEC 14 AM 9:43

For corners in OTTAWA

D. J. Vugteveen
REGISTER OF DEEDS
OTTAWA COUNTY, MI

	Located In:		Corner Code #
1. Public Land Survey	T <u>6N</u>	R <u>13W</u>	M-6 (E 1/4 cor of Sec 13) Georgetown Twp.
	T _____	R _____	_____
	T _____	R _____	_____
	T _____	R _____	_____
2. Property Controlling in Section	S _____	T _____	R _____
	S _____	T _____	R _____
3. Miscellaneous Property in Sec.	S _____	T _____	R _____
	S _____	T _____	R _____

Register of Deeds Stamp & File Number

4. Lot No. _____, Recorded Plat _____
5. Private Claims _____

	A	B	C	D	E	F	G	H	I	J	K	L	M
2	6		5		4		3		2				
3													
4	7		8		9		10		11		12		
5													
6	18		17		16		15		14		13		
7													
8	19		20		21		22		23		24		
9													
10	30		29		28		27		26		25		
11													
12	31		32		33		34		35		36		
13													

I, Randal J. Vugteveen, in a field survey on November 29, 1994

do hereby certify that under requirements of P.A. 74, Michigan P.A. of 1970, the corner points mentioned in lines 1 and 2 above were in conformance with regulations and rules therefore as required in the current manual of survey instructions of the United States Department of the Interior, Bureau of Land Management or by a decree of a Court of Law and/or that the corner points mentioned in lines 3, 4 and 5 above were in conformance with the rules of the Michigan Board of Land Surveyors or by a Decree of a Court of Law; established, re-established, monumented, re-monumented, recovered, found as expressed below:

NOTE: Not more than 4 corners, all in the same town and range, may be recorded on this certificate.

A. Description of original monument and accessories and/or subsequent restoration:

M-6 common corner to Section 15	Liber 3, Page 201
1831 - Lyon & Sibley	Spike in E side 10" Crab Apple SW 6.47'
Set H.M.P.	Spike in E side 8" Crab Apple N 25.08'
Beech 26" S42W 26 Links	Spike in SW side 12" Ash NW 64.38'
Lynn 8" N12W 45 Links	Prev. held as common corner with Section 18-6-12


B. Description of corner evidence found and/or method applied in restoring or reestablishing corner:
M-6 Found KCRM CIN 256' N of centerline "X" of Baldwin & RR tracks and accepted as a careful and faithful perpetuation of the position of the original corner

Spike in E side 10" Crab Apple SW 6.46'
Spike in E side 8" Crab Apple N 25.00'

P.A. 845 OTTAWA COUNTY
PEER APPROVED 12/12/94
Kristy P. Hedewell

C. Description of monument for corner and accessories established to perpetuate locating the position of the corner:
M-6 Cast Iron Monument (Common Corner with Section 18-6-12)

AZ = Michigan State Grid Direction
Set Ottawa County Remon Tag & Nail in E side 12" Twin Crab Apple AZ. 230 deg 6.46'
Set Ottawa County Remon Tag & Nail in E side 20" Crab Apple AZ. 350 deg 25.04'
Set Ottawa County Remon Tag & Nail in N side 14" Oak AZ. 100 deg 27.37'
NE foundation corner of pole barn to house #023 AZ. 177 deg 135.34'

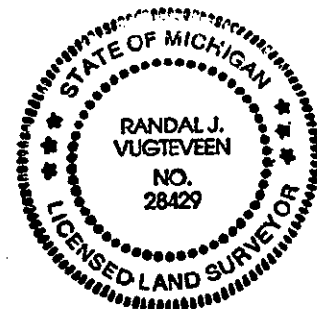

Signed by *Randal J. Vugteveen*
Surveyor's Michigan License No. 28429

Date Dec 12, 1994