

SURVEY & REMONUMENTATION

APR 24 1995

OTTAWA COUNTY REMONUMENTATION

RECORDED

COMMISSION

LAND CORNER RECORDATION CERTIFICATE
Filing Requirement of Act 74, Mich. P.A. 1970.

94 DEC 14 AM 9:40

For corners in
OTTAWA
(County)

Located In: Corner Code #

Deborah K. Hillman
REGISTER OF DEEDS
OTTAWA COUNTY, MI

- | | | | |
|------------------------------------|----|-----|------------------------|
| 1. Public Land Survey | 6N | 13W | M-7 (SE cor of Sec 13) |
| | T | R | Georgetown Twp. |
| | T | R | |
| | T | R | |
| 2. Property Controlling in Section | S | T | R |
| | S | T | R |
| 3. Miscellaneous Property in Sec. | S | T | R |
| | S | T | R |
4. Lot No. _____, Recorded Plat _____
5. Private Claims _____

Register of Deeds Stamp & File Number

	A	B	C	D	E	F	G	H	I	J	K	L	M
2	6	5	4	3	2	1							
3													
4	7	8	9	10	11	12							
5													
6	18	17	16	15	14	13							
7													
8	19	20	21	22	23	24							
9													
10	30	29	28	27	26	25							
11													
12	31	32	33	34	35	36							
13													

I, Randal J. Vugteveen, in a field survey on November 29, 19 94, do hereby certify that under requirements of P.A. 74, Michigan P.A. of 1970, the corner points mentioned in lines 1 and 2 above were in conformance with regulations and rules therefore as required in the current manual of survey instructions of the United States Department of the Interior, Bureau of Land Management or by a decree of a Court of Law and/or that the corner points mentioned in lines 3, 4 and 5 above were in conformance with the rules of the Michigan Board of Land Surveyors or by a Decree of a Court of Law; established, re-established, monumented, re-monumented, recovered, found as expressed below:

NOTE: Not more than 4 corners, all in the same town and range, may be recorded on this certificate.

A. Description of original monument and accessories and/or subsequent restoration:

M-7 common corner to Section 13

1831 - Lyon & Sibley

Set post

Hickory 5" S36W 25 Links

Beech 20" N40W 24 Links

Liber 1, Page 469

MSHD nail & tag in centerline CP pole

S65 $\frac{1}{2}$ W 57.94' / MSHD nail & tag in

centerline guy & MBT pole N35 $\frac{1}{2}$ W 36.57' /

MSHD nail & tag in centerline CP & MBT

pole S55 $\frac{1}{2}$ E 36.55' / MSHD nail & tag in

centerline CP & MBT pole N30 $\frac{1}{2}$ E 50.08'

Liber 5, Page 340 / S cor gar fnd N65 $\frac{1}{2}$ E

131.25' / SE cor hse fnd N45 $\frac{1}{2}$ W 75.40' / NE

cor hse fnd S40 $\frac{1}{2}$ W 110.00' / NW cor hse fnd

S40 $\frac{1}{2}$ E 115.68' / Nail & tag N side P pole

S50 $\frac{1}{2}$ E 36.45' / Nail & tag N side P pole

N32 $\frac{1}{2}$ W 36.44' / PK nail N side P pole N40 $\frac{1}{2}$ E

58.37' / SE cor bottom con step to hse

#7211 Kenowa N42 $\frac{1}{2}$ W 73.53'

B. Description of corner evidence found and/or method applied in restoring or reestablishing corner:

M-7 Found KCRM CIM at centerline "X" of Tyler & Kenowa and accepted as a careful and faithful perpetuation of the position of the original corner

S cor gar fnd N65 $\frac{1}{2}$ ZE 131.32' / SE cor hse

fnd N45 $\frac{1}{2}$ ZW 75.50' / NE cor hse fnd

S40 $\frac{1}{2}$ ZW 110.00' / NW cor hse fnd S40 $\frac{1}{2}$ ZE

115.68' / PK nail N side P pole N40 $\frac{1}{2}$ ZE

58.48' / SE cor bottom conc step to hse

#7211 Kenowa N42 $\frac{1}{2}$ ZW 73.53' / PK nails W &

N 2.00' / Centerline of road N-S, E-W

PA. 0345 OTTAWA COUNTY
PEER APPROVED 12/12/94

Randal J. Vugteveen

C. Description of monument for corner and accessories established to perpetuate locating the position of the corner:

M-7 Cast Iron Monument in mon box (Held as Common with Kent County Corner)


AZ = Michigan State Grid Direction

South corner foundation garage #3590 AZ. 66 deg 131.32'

SE foundation corner house #7211 AZ. 313 deg 75.50'

NW foundation corner house #4790 AZ. 140 deg 115.70'

NE corner brick house #7189 AZ. 220 deg 109.80'

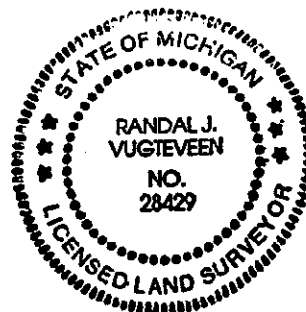

Signed by

Randal J. Vugteveen

Date

DEC 12, 1994

Surveyor's Michigan License No.

28429

FORM APPROVED BY MICHIGAN STATE BOARD OF LAND SURVEYORS, JAN. 28, 1971
REVISED MAY 14, 1975
REVISED JAN., 1983