

APR 05 1996

COMMISSION

OTTAWA COUNTY REMONUMENTATION

LAND CORNER RECORDATION CERTIFICATE  
Filing Requirement of Act 74, Mich. P.A. 1970

For corners in  
OTTAWA  
(County)

Located In: Corner Code #  
1. Public Land Survey T6N R13W M-12 (E 1/4 cor Section 36) Georgetown Twp.  
T R  
T R  
T R  
2. Property Controlling in Section S T R  
S T R  
3. Miscellaneous Property in Sec. S T R  
S T R

RECORDED

95 NOV 15 PM 2:10

*Phyllis Kullman*  
REGISTER OF DEEDS  
OTTAWA COUNTY, MI

Register of Deeds Stamp & File Number

4. Lot No. \_\_\_\_\_, Recorded Plat \_\_\_\_\_  
5. Private Claims \_\_\_\_\_

	A	B	C	D	E	F	G	H	I	J	K	L	M
2	6	5	4	3	2	1							
3													
4	7	8	9	10	11	12							
5													
6	16	17	16	15	14	13							
7													
8	19	20	21	22	23	24							
9													
10	30	29	28	27	26	25							
11													
12	31	32	33	34	35	36							
13													

I, Randal J. Vugteveen, in a field survey on October 18, 19 95, do hereby certify that under requirements of P.A. 74, Michigan P.A. of 1970, the corner points mentioned in lines 1 and 2 above were in conformance with regulations and rules therefore as required in the current manual of survey instructions of the United States Department of the Interior, Bureau of Land Management or by a decree of a Court of Law and/or that the corner points mentioned in lines 3, 4 and 5 above were in conformance with the rules of the Michigan Board of Land Surveyors or by a Decree of a Court of Law; established, re-established, monumented, re-monumented, recovered, found as expressed below.

**NOTE: Not more than 4 corners, all in the same town and range, may be recorded on this certificate.**

A. Description of original monument and accessories and/or subsequent restoration:  
M-12 Common corner to Section 36

1831 - sibley	Liber 3, Page 299	Liber
Set post	3/4" iron	Common with W 1/4 cor, Sec. 31, T6N, R12W.
Beech S38 1/2 W46 10 Links	PK in side p pole NE 51.49'	CIM
Beech N10 W18 7 Links	Center fire hydrant NW 36.85'	Nail & Remon tag in NW side PP NE 51.58'
	NW cor hse SE 84.40'	NW cor hse fndn SE 84.48'
	PK in side p pole SW 51.07'	Nail & Remon tag in SE side PP SW 50.95'


B. Description of corner evidence found and/or method applied in restoring or reestablishing corner:

M-12 Found KCRM CIM marked "A-12" T6N R12W 2' S of centerline "X" Kenowa Ave & 56th St. E & Barry St. W and accepted as a careful and faithful perpetuation of the position of the original corner  
PK in side p. pole NE 51.49'  
NW corner house SE 84.40'  
PK in side p. pole SW 51.07'

PA. 345 OTTAWA COUNTY  
PEER APPROVED 10/23/95  
*YDY* *Andrey D. Medvedev*

C. Description of monument for corner and accessories established to perpetuate locating the position of the corner:

M-12 Cast Iron Monument  
Set Ottawa County Remon Nail & Tag above KCRM Nail & Tag NE side p. pole Az. 313 deg 61.50'  
SE corner brick Georgetown Twp metering station Az. 315 deg 103.82'  
Top centerline hydrant Az. 23 deg 74.84'  
Set Ottawa County Remon Nail & Tag below KCRM Nail & Tag in NW side P. pole Az. 42 deg 51.57'  
Top centerline hydrant Az. 159 deg 73.19'  
Set Ottawa County Remon Nail & Tag below KCRM Nail & Tag W SE side P. pole Az. 225 deg 50.99'  
NW foundation corner hse #5610 Az. 135 deg 84.39'

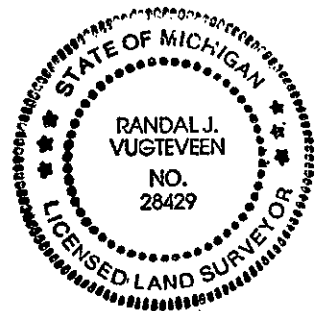

Signed by *Randal J. Vugteveen* Date Oct 20, 1995  
Surveyor's Michigan License No. 28429