

# SURVEY & REMONUMENTATION

OCT 07 1995

## OTTAWA COUNTY REMONUMENTATION

### COMMISSION

### LAND CORNER RECORDATION CERTIFICATE Filing Requirement of Act 74, Mich. P.A. 1970

For corners in  
OTTAWA  
(County)

Located In: Corner Code #

1. Public Land Survey

T6N R13 M-13 (SE corner Section 36) Georgetown Twp.

2. Property Controlling in Section  
3. Miscellaneous Property in Sec.

S \_\_\_ T \_\_\_ R \_\_\_  
S \_\_\_ T \_\_\_ R \_\_\_  
S \_\_\_ T \_\_\_ R \_\_\_  
S \_\_\_ T \_\_\_ R \_\_\_

4. Lot No. \_\_\_\_\_, Recorded Plat \_\_\_\_\_  
5. Private Claims \_\_\_\_\_

RECORDED

96 AUG 26 PH 2: 02

*Randal J. Vugteveen*  
REGISTER OF DEEDS  
OTTAWA COUNTY, MI

Register of Deeds Stamp & File Number

I, Randal J. Vugteveen, in a field survey on October 19, 19 95, do hereby certify that under requirements of P.A. 74, Michigan P.A. of 1970, the corner points mentioned in lines 1 and 2 above were in conformance with regulations and rules therefore as required in the current manual of survey instructions of the United States Department of the Interior, Bureau of Land Management or by a decree of a Court of Law and/or that the corner points mentioned in lines 3, 4 and 5 above were in conformance with the rules of the Michigan Board of Land Surveyors or by a Decree of a Court of Law; established, re-established, monumented, re-monumented, recovered, found as expressed below:

A	B	C	D	E	F	G	H	I	J	K	L
2	6	5	4	3	2						
3											
4	7	8	9	10	11	12					
5											
6	18	17	16	15	14	13					
7											
8	19	20	21	22	23	24					
9											
10	30	29	28	27	26	25					
11											
12	31	32	33	34	35	36					
13											

**NOTE: Not more than 4 corners, all in the same town and range, may be recorded on this certificate.**

A. Description of original monument and accessories and/or subsequent restoration:

M-13 Common Township Corner  
1831 - Sibley  
Set HMP  
Beech S18 W71 25 Links  
Beech N13 W24 6 Links

Common Corner per all previous information recorded in L.C.R.C. #1548 Kent County as NW corner of Section 6, T5N, R12W, and SW corner of Section 36, T6N, R12W

B. Description of corner evidence found and/or method applied in restoring or reestablishing corner:

M-13 Found KCRM CIM @ centerline "X" Kenowa Avenue & 60th St. E & Jackson St. W and accepted as a careful and faithful perpetuation of the position of the original corner  
Found KCRM Nail & Tag in SW side 18"  
Cottonwood Az. 305 deg 90.82' / Found KCRM Nail & Tag in SE side p. pole Az. 20 deg 104.48' / Found KCRM Nail & Tag in N side p. pole Az. 135 deg. 50.12'


P.A. 345 OTTAWA COUNTY  
PEER APPROVED 2-19-96

*Randal J. Vugteveen*

C. Description of monument for corner and accessories established to perpetuate locating the position of the corner:

M-13 Kent County Remon Monument

Set Ottawa County Remon Nail & Tag above KCRM Nail & Tag in SW side 18" Cottonwood Az. 305 deg 90.82'  
Set Ottawa County Remon Nail & Tag above KCRM Nail & Tag in SE side p. pole Az. 20 deg 104.48'  
Set Ottawa County Remon Nail & Tag above KCRM Nail & Tag in N side p. pole Az. 135 deg 50.12'  
NE foundation corner garage #4785 Kenowa Az. 236 deg 110.54'

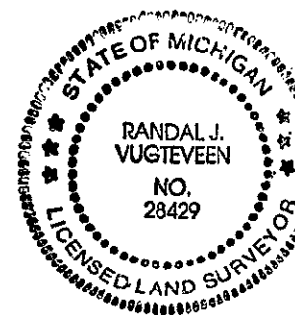

Signed by *Randal J. Vugteveen*  
Surveyor's Michigan License No. 28429

Date Dec 8, 1995

FORM APPROVED BY MICHIGAN STATE BOARD OF LAND SURVEYORS, JAN. 28, REVISER MAY 14, REVISED JAN.