

FEB 24 2000

SECTION

OTTAWA COUNTY REMONUMENTATION

RECORDED

99 JUL 30 PM 12: 26

LAND CORNER RECORDATION CERTIFICATE  
Filing Requirement of Act 74, Mich. P.A. 1970

*Larry Schmitt*  
REGISTER OF DEEDS  
OTTAWA COUNTY, MI

For corners in  
OTTAWA

Located In: Corner Code #

- |                                    |   |    |   |     |                  |
|------------------------------------|---|----|---|-----|------------------|
| 1. Public Land Survey              | T | 6N | R | 13W | E-1 NW Cor Sec 4 |
|                                    | T |    | R |     | Georgetown Twp   |
|                                    | T |    | R |     |                  |
|                                    | T |    | R |     |                  |
| 2. Property Controlling in Section | S |    | T | R   |                  |
|                                    | S |    | T | R   |                  |
| 3. Miscellaneous Property in Sec.  | S |    | T | R   |                  |
|                                    | S |    | T | R   |                  |

*Fig. 2*

Register of Deeds Stamp & File Number

4. Lot No. \_\_\_\_\_, Recorded Plat \_\_\_\_\_  
5. Private Claims \_\_\_\_\_

Randal J. Vugteveen March 16 99

I, \_\_\_\_\_, in a field survey on \_\_\_\_\_, 19\_\_\_\_ do hereby state that under requirements of P.A. 74, Michigan P.A. of 1970, the corner points mentioned in lines 1 and 2 above were in conformance with regulations and rules therefore as required in the current manual of survey instructions of the United States Department of the Interior, Bureau of Land Management or by a decree of a Court of Law and/or that the corner points mentioned in lines 3, 4 and 5 above were in conformance with the rules of the Michigan Board of Land Surveyors or by a Decree of a Court of Law; established, re-established, monumented, recovered, found as expressed below:

NOTE: Not more than 2 corners, all in the same town and range, may be recorded on this certificate.

A	B	C	D	E	F	G	H	I	J	K	L	M
1												
2	6	5	4	3	2	1						
3												
4	7	8	9	10	11	12						
5												
6	18	17	16	15	14	13						
7												
8	19	20	21	22	23	24						
9												
10	30	29	28	27	26	25						
11												
12	31	32	33	34	35	36						
13												

A. Description of original monument and accessories and/or subsequent restoration:

E-1 GLO Sibley  
Jan 1832  
Set post 87 Links  
East of Post  
9" Beech S82°W 9 Links  
7" Lynn S54°E 19 Links

E-1 Liber 5 Page 227  
Exxel 1985  
E-1 Set re-rod with Exxel Cap on Twp. line 0.42  
North of 1/2" X 3" steel plate.  
Nail in NW sde dbl. 14" Basswood SW 56.50'  
Nail in NE Sde dbl 10" Elm WNW 28.24'  
Nail in W sde 6" W Cherry North 11.42'  
Nail in NE sde 6" crab apple SE 30.80'

Traces of old wire fence S & W  
1" solid steel bar West 57.63'  
(SW Cor Sec 33)

B. Description of corner evidence found and/or method applied in restoring or reestablishing corner:

E-1 Fd Exxel Cap on Twp Line 0.42' North of 3" Steel Plate

Fd Ottawa County Remon Bar & Cap at SW cor Sec 33 West 57.63'  
Fd Nail in NW side Dbl 14" Brasswood SW 56.60'  
Fd Nail in W side 6" W Cherry N 11.42'  
Fd Nail in NE side 6" Crab Apple SE 30.80'  
Traces of Old Wire Fence S & W 0.0'

Accepted 3" Steel Plate as the best available evidence of the position of the corner. Accepted Exxel Rerod as the best available evidence for the position of the Amended Corner.


Removed Exxel capped iron and replaced with a 3/4" X 36" Solid Bar with Ottawa County Remon Cap at the Amended Corner.

C. Description of monument for corner and accessories established to perpetuate locating the position of the corner:

E-1 Removed and set 3/4" X 36" solid bar with Ottawa County Remon cap

Set Ottawa County Remon Nail & Tag in W side 8" Cherry N0°E 11.42'  
Set Ottawa County Remon Nail & Tag in N side 6" Crab Apple S40°E 30.80'  
Set Ottawa County Remon Nail & Tag in NE side Twin 12" Elm N60°W 27.97'  
Set Ottawa County Remon Nail & Tag in NW side Basswood clump S60°W 56.52'  
Found Ottawa County Remon Cap (Tallmadge cor) N90°W 57.63'  
1/2" X 3" Steel Plate South 0.42'

FILED APPROVED 3/22/99

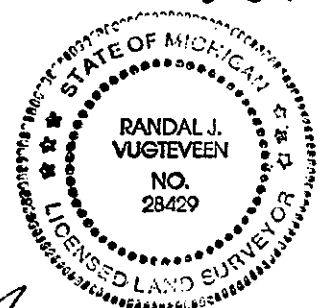

\$11.00 CORNER  
Receipt #52389

Signed by *Randal J. Vugteveen*  
Surveyor's Michigan License No. 28429

Date MARCH 16, 1999