

FEB 24 2000

SECTION

OTTAWA COUNTY REMONUMENTATION

LAND CORNER RECORDATION CERTIFICATE
Filing Requirement of Act 74, Mich. P.A. 1970

RECORDED

99 SEP -9 PM 12: 15

For corners in

Ottawa

(County)

Located in:

Corner Code #

Blendon Twp. A-11 NW Cor
6N 14W Sec. 31

1. Public Land Survey

T ___ R ___
T ___ R ___
T ___ R ___
T ___ R ___

2. Property Controlling in Section

S ___ T ___ R ___
S ___ T ___ R ___

3. Miscellaneous Property in Sec.

S ___ T ___ R ___
S ___ T ___ R ___

Randal D. Feenstra
REGISTER OF DEEDS
OTTAWA COUNTY, MI

Register of Deeds Stamp & File Number

4. Lot No. _____, Recorded Plat _____
5. Private Claims _____

Randal D. Feenstra

Feb. 11 99

I, _____, in a field survey on _____, 19____ do hereby state that under requirements of P.A. 74, Michigan P.A. of 1970, the corner points mentioned in lines 1 and 2 above were in conformance with regulations and rules therefore as required in the current manual of survey instructions of the United States Department of the Interior, Bureau of Land Management or by a decree of a Court of Law and /or that the corner points mentioned in lines 3, 4 and 5 above were in conformance with the rules of the Michigan Board of Land Surveyors or by a Decree of a Court of Law, established, re-established, monumented, recovered, found as expressed below:

NOTE: Not more than 2 corners, all in the same town and range, may be recorded on this certificate.

	A	B	C	D	E	F	G	H	I	J	K	L	M
1													
2	6		5		4		3		2		1		
3													
4	7		8		9		10		11		12		
5													
6	18		17		16		15		14		13		
7													
8	19		20		21		22		23		24		
9													
10	30		29		28		27		26		25		
11													
12	31		32		33		34		35		36		
13													


A. Description of original monument and accessories and/or subsequent restoration:
G.L.O. By Calvin Britain L-1, P-663, 1972 (Roan)
April 18, 1832 A-11 Found 3/4" pipe in concrete
Set Post Telephone Pole NW 55.00'
3" Tamarack S23°E NW Cor. E Hdwl SSE 50.92
16 links NE Cor. W Hdwl SSW 50.60
8" Tamarack N47°E
26 links (Continued on other side)

B. Description of corner evidence found and/or method applied in restoring or reestablishing corner:

A-11 Found: Cast Iron Monument in monument box 0.08' E of Olive Twp. Line
Found: Nail and Tag NE Side of Power Pole AZ 147°0' 92.69'
Found: Centerline on top of Hydrant AZ 96°40' 35.08'
Found: Cast Iron Monument in monument box (Olive Cor.) South 30.46'

Accepted as a careful and faithful perpetuation of the position of the original corner.

APPROVED 8/30/99

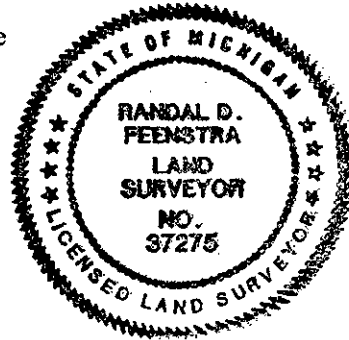

C. Description of monument for corner and accessories established to perpetuate locating the position of the corner:

A-11 Cast Iron Monument in monument box (See Sketch)
Set Ottawa County Remon Nail & Tag in W side of Fence Post AZ 32°30' 77.18'
Set Ottawa County Remon Nail & Tag in S side of Fence Post AZ 97°45' 43.84"
Set Ottawa County Remon Nail & Tag in NE side of Power Pole AZ 147°00' 92.69'
Centerline top of Hydrant AZ 96°40' 35.08'
SE Cor. House foundation AZ 300°10' 161.41
Cast Iron Monument in monument box (Olive Twp. Cor.) South 30.46'
Centerline N-S bituminous road (96th Ave.) East 2.0'
On centerline ditch to East
Centerline gravel road to West (Van Buren St.) South 25.0'

\$2.00 PHOTO
Receipt #56820
\$11.00 CORNER
Receipt #56820

Signed by *Randal D. Feenstra*
Surveyor's Michigan License No. 37275

Date May 14, 1999

FEB 24 2000

SECTION

L-6, P-13, 1989 (Joiner)

Part B	Found Square Iron	Part C	Set Cast Iron Monument		
	Telephone Pole	NW	55.00	NW	55.29
	NW Cor. E. Hdwl	SSE	50.92	SSW	99.85
	NE Cor. W Hdwl	SSW	50.60	E	35.13
				SE	92.81
				S	30.41

