

SURVEY & REMONUMENTATION

DEC 16 1996

OTTAWA COUNTY REMONUMENTATION

COMMISSION

LAND CORNER RECORDATION CERTIFICATE
Filing Requirement of Act 74, Mich. P.A. 1970

For corners in
Ottawa
(County)

Located In:	Corner Code #
Blendon Twp. 6N 14W	B-3, S 1/4 cor. Sec. 6
T ___ R ___	_____
T ___ R ___	_____
T ___ R ___	_____
T ___ R ___	_____
S ___ T ___ R ___	_____
S ___ T ___ R ___	_____
S ___ T ___ R ___	_____
S ___ T ___ R ___	_____

1. Public Land Survey

2. Property Controlling in Section

3. Miscellaneous Property in Sec.

4. Lot No. _____, Recorded Plat _____
5. Private Claims _____

RECORDED

96 NOV 14 AM 11:20

Ralph L. Hallman
REGISTER OF DEEDS
OTTAWA COUNTY, MI

Register of Deeds Stamp & File Number

I, Randal D. Feenstra, in a field survey on February 20, 19 96 do hereby state that under requirements of P.A. 74, Michigan P.A. of 1970, the corner points mentioned in lines 1 and 2 above were in conformance with regulations and rules therefore as required in the current manual of survey instructions of the United States Department of the Interior, Bureau of Land Management or by a decree of a Court of Law and/or that the corner points mentioned in lines 3, 4 and 5 above were in conformance with the rules of the Michigan Board of Land Surveyors or by a Decree of a Court of Law; established, re-established, monumented, recovered, found as expressed below:

NOTE: Not more than 2 corners, all in the same town and range, may be recorded on this certificate.

	A	B	C	D	E	F	G	H	I	J	K	L	M
1													
2		6		5		4		3		2		1	
3		•											
4		7		8		9		10		11		12	
5													
6		18		17		16		15		14		13	
7													
8		19		20		21		22		23		24	
9													
10		30		29		28		27		26		25	
11													
12		31		32		33		34		35		36	
13													

A. Description of original monument and accessories and/or subsequent restoration:

G.L.O. (1832)
Calvin Britain
Post
5" Hemlock N13°W 15 lks.
5" Hemlock S34°E 20 lks.

LIBER 5, PAGE 107 (1985)
Rerod top of fld. solid flat steel
Rerod S 68°E 18.23'
Rerod S 68°W 19.08'
Rerod N 0°E 28.56'

LIBER 5, PAGE 325 (1988)
C.I.M.
No Witnesses within a reasonable distance

B. Description of corner evidence found and/or method applied in restoring or reestablishing corner:

Found: C.I.M. in box Accepted as a careful and faithful perpetuation of the position of the original corner.


Rerod S 57°E 18.38'
Rerod S 59°W 19.46' (leaning to West)

P.A. 345 OTTAWA COUNTY
PEER APPROVED 9-16-96
R.D.F.

C. Description of monument for corner and accessories established to perpetuate locating the position of the corner:

B-3 C.I.M. in Box

Ottawa County Remon. Nail & Tag in S. side 26" maple	AZ 283°	506.10'
Ottawa County Remon. Nail & Tag in N side P. Pole	AZ 108°	333.16'
Ottawa County Remon. Nail & Tag in W side P. Pole	AZ 165°	43.25'
NW Cor. conc. blk. fdtn. to gar.	AZ 165°	268.21'
Centerline Taylor. (bit. conc.) N 6.3'		

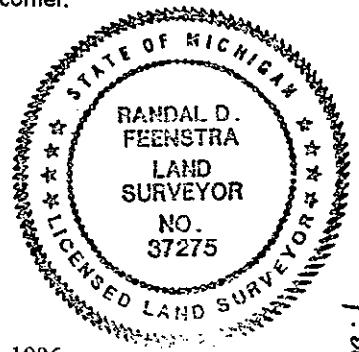

Signed by *Randal D. Feenstra*
Surveyor's Michigan License No. 37275

Date February 20, 1996