

OTTAWA COUNTY REMONUMENTATION

LAND CORNER RECORDATION CERTIFICATE
Filing Requirement of Act 74, Mich. P.A. 1970

For corners in

Ottawa

(County)

Located in:

Corner Code #

1. Public Land Survey

Blendon Twp.

C-1, NE cor.

T 6N R 14W Sec. 6

2. Property Controlling in Section

S T R

3. Miscellaneous Property in Sec.

S T R

RECORDED

96 DEC 17 AM 10:44

Randal D. Feenstra
REGISTER OF DEEDS
OTTAWA COUNTY, MI

Register of Deeds Stamp & File Number

4. Lot No. _____, Recorded Plat _____

5. Private Claims _____

I, Randal D. Feenstra, in a field survey on February 12, 1996 do hereby state that under requirements of P.A. 74, Michigan P.A. of 1970, the corner points mentioned in lines 1 and 2 above were in conformance with regulations and rules therefore as required in the current manual of survey instructions of the United States Department of the Interior, Bureau of Land Management or by a decree of a Court of Law and for that the corner points mentioned in lines 3, 4 and 5 above were in conformance with the rules of the Michigan Board of Land Surveyors or by a Decree of a Court of Law; established, re-established, monumented, recovered, found as expressed below:

NOTE: Not more than 2 corners, all in the same town and range, may be recorded on this certificate.

A	B	C	D	E	F	G	H	I	J	K	L	M
1		●										
2	6	5	4	3	2	1						
3												
4	7	8	9	10	11	12						
5												
6	18	17	16	15	14	13						
7												
8	19	20	21	22	23	24						
9												
10	30	29	28	27	26	25						
11												
12	31	32	33	34	35	36						
13												

A. Description of original monument and accessories and/or subsequent restoration:

G.L.O. (1832)

Calvin Britain
Post
10" Beech S56°W 15 lks.

LIBER 4, PAGE 134 (1980)

C.I.M.
P. Pole ENE 95.36'
T. Pole SE 55.97'
37" B.Cherry N 29.17'
18" Twin Oak NW 52.90'
Allendale Cor. E 42.22

LIBER 6, PAGE 129 (1991)

Cast Iron Monument
Allendale Cor. E 42.20'
Nail W. Side Post SE 56.84'
Nail N Side Twin 8" Elm SW 86.96'
Nail SW Root 30" Cherry N 28.59'
Nail S Side P. Pole NE 95.87'

B. Description of corner evidence found and/or method applied in restoring or reestablishing corner:

Found: Broken Cast Iron Monument in box

Accepted as a careful and faithful perpetuation of the position of the original corner.


Nail SW Root 30" Cherry N 28.57'
Allendale Cor. E 42.14'

P.A. 345 OTTAWA COUNTY
PEER APPROVED 11-11-96

RDF


C. Description of monument for corner and accessories established to perpetuate locating the position of the corner:

C-1 Broken Cast Iron Monument in Box (D.11' N. OF TOWNLINE - SEE SKETCH ON BACK)
Ottawa County Remon. Nail & Tag in SW root 36" Cherry AZ 354° 28.54'
Ottawa County Remon. Nail & Tag in S root 30" Twin Oak AZ 292° 62.32'
Ottawa County Remon. Nail & Tag in NW side P. Pole AZ 73° 95.76'
Ottawa County Remon. Nail & Tag in SW side Post AZ 134° 56.46'
Allendale Cor. Cast Iron Monument in Monument Box E 42.14'

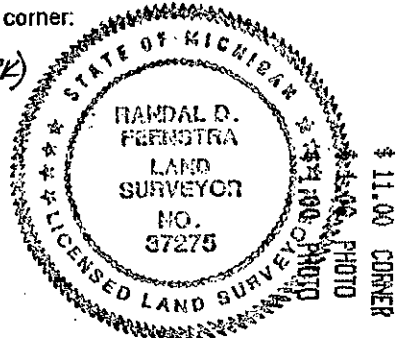

Signed by Randal D. Feenstra
Surveyor's Michigan License No. 37275

Date February 12, 1996

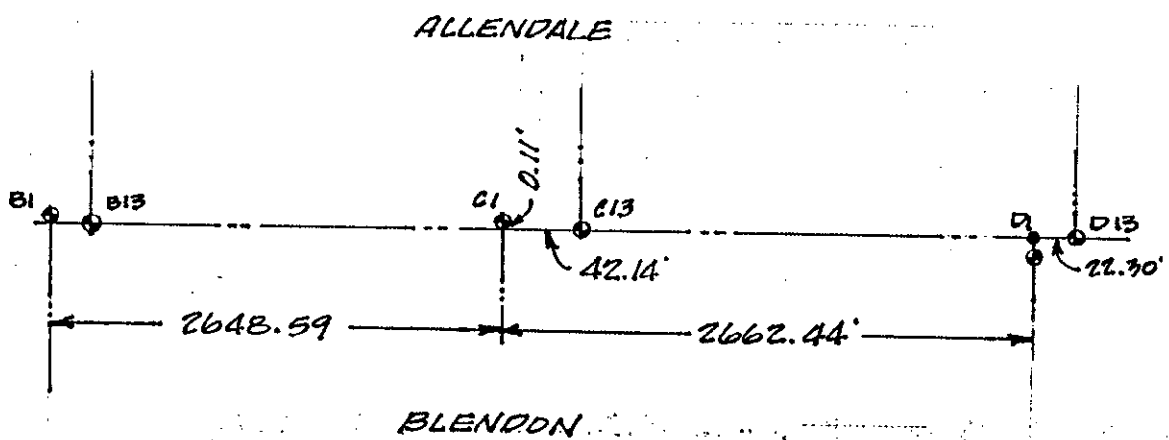

NOTE: G.L.D. INFORMATION INDICATES A DISTANCE OF 42.24' FROM C1 TO C13