

**SURVEY &  
REMONUMENTATION**

DEC 1 6 1996

COMMISSION

**OTTAWA COUNTY REMONUMENTATION**

**LAND CORNER RECORDATION CERTIFICATE  
Filing Requirement of Act 74, Mich. P.A. 1970**

For corners in  
Ottawa

(County)

Located In:

Corner Code #

1. Public Land Survey		Blendon Twp.	
		6 <sup>N</sup> R 14 <sup>W</sup>	C-2, E 1/4 cor.
		T ___ R ___	Sec. 6
		T ___ R ___	
		T ___ R ___	
2. Property Controlling in Section	S ___	T ___ R ___	
	S ___	T ___ R ___	
3. Miscellaneous Property in Sec.	S ___	T ___ R ___	
	S ___	T ___ R ___	

**RECORDED**

96 NOV 14 AM 11:20

*Randal D. Feenstra*  
REGISTER OF DEEDS  
OTTAWA COUNTY, MI

Register of Deeds Stamp & File Number

4. Lot No. \_\_\_\_\_, Recorded Plat \_\_\_\_\_  
5. Private Claims \_\_\_\_\_

I, Randal D. Feenstra, in a field survey on February 20, 19 96 do hereby state that under requirements of P.A. 74, Michigan P.A. of 1970, the corner points mentioned in lines 1 and 2 above were in conformance with regulations and rules therefore as required in the current manual of survey instructions of the United States Department of the Interior, Bureau of Land Management or by a decree of a Court of Law and /or that the corner points mentioned in lines 3, 4 and 5 above were in conformance with the rules of the Michigan Board of Land Surveyors or by a Decree of a Court of Law; established, re-established, monumented, recovered, found as expressed below:

NOTE: Not more than 2 corners, all in the same town and range, may be recorded on this certificate.

A	B	C	D	E	F	G	H	I	J	K	L	M
1												
2	6	●	5		4		3		2		1	
3												
4	7		8		9		10		11		12	
5												
6	18		17		16		15		14		13	
7												
8	19		20		21		22		23		24	
9												
10	30		29		28		27		26		25	
11												
12	31		32		33		34		35		36	
13												

A. Description of original monument and accessories and/or subsequent restoration:

G.L.O. (1832)  
Calvin Britain  
18" Elm is Post

LIBER 1, PAGE 493 (1972)  
"T" Iron  
T. Pole NW 43.95'  
P. Pole NW 51.75'  
P. Pole ESE 56.98'  
G. Pole NE 49.31'

LIBER 4, PAGE 218 (1981)  
Cast Iron Monument  
St. Sign W 13.23'  
P. Pole NW 51.77'  
P. Pole NE 49.10'  
P. Pole SE 56.86'

B. Description of corner evidence found and/or method applied in restoring or reestablishing corner:

Found: Broken Cast Iron Monument in Gravel Road:


Accepted as a careful and faithful perpetuation of the position of the original corner.

Pk Nail in SW side P. Pole AZ 333° 51.61'  
Pk Nail in N side P. Pole AZ 115° 56.60'  
Nail in SE side P. Pole AZ 31° 49.13'

APPROVED 9-16-96  
*R.D.F.*

C. Description of monument for corner and accessories established to perpetuate locating the position of the corner:

C-2 Broken Cast Iron Monument in Gravel Road  
Ottawa County Remon. Nail & Tag in Sw. side P. Pole AZ 333° 51.61'  
Ottawa County Remon. Nail & Tag in SE side P. Pole AZ 31° 49.03'  
Ottawa County Remon. Nail & Tag in N side P. Pole AZ 115° 56.60'  
Ottawa County Remon. Nail & Tag in N side P. Pole AZ 259° 95.99'  
Centerline 88th Ave. (Gravel N & S) W 2.0'  
Centerline Stanton St. (Gravel E) N 17.0'

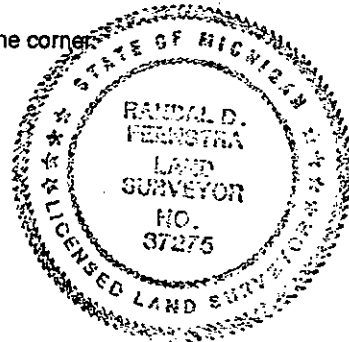

Signed by *Randal D. Feenstra*  
Surveyor's Michigan License No. 37275

Date February 20, 1996