

**SURVEY & REMONUMENTATION**

OCT 24 1994

**COMMISSION**

**OTTAWA COUNTY REMONUMENTATION  
LAND CORNER RECORDATION CERTIFICATE  
Filing Requirement of Act 74, Mich. P.A. 1970**

**RECORDED**


91 OCT -7 PM 12:33

*Phyllis Bellman*  
REGISTER OF DEEDS  
OTTAWA COUNTY, MI

For corners in

<u>Ottawa</u> (County)	Located In:	Corner Code #:
1. Public Land Survey	T <u>6N</u> R <u>14W</u>	<u>C-4, W 1/4 COR</u> <u>Sec. 8, Blendon</u>
	T _____ R _____	_____
	T _____ R _____	_____
	T _____ R _____	_____
2. Property Controlling in Section	S _____ T _____ R _____	_____
	S _____ T _____ R _____	_____
3. Miscellaneous Property in Sec.	S _____ T _____ R _____	_____
	S _____ T _____ R _____	_____
4. Lot No. _____, Recorded Plat _____		
5. Private Claims _____		

Register of Deeds Stamp & File Number

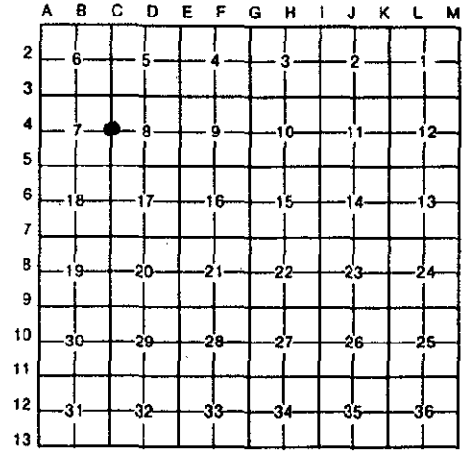

I, Randal D. Feenstra in a field survey on May 9, 19 94, do hereby certify that under requirements of P.A. 74, Michigan P.A. of 1970, the corner points mentioned in lines 1 and 2 above were in conformance with regulations and rules therefore as required in the current manual of survey instructions of the United States Department of the Interior, Bureau of Land Management or by a decree of a Court of Law and/or that the corner points mentioned in lines 3, 4 and 5 above were in conformance with the rules of the Michigan Board of Land Surveyors or by a Decree of a Court of Law; established, re-established, monumented, re-monumented, recovered, found as expressed below:

**NOTE: Not more than 4 corners, all in the same town and range, may be recorded on this certificate.**

A. Description of original monument and accessories and/or subsequent restoration:		Liber 2, Pg. 585 (1974)		Liber 4, Pg. 133 (1980)		Liber 5, Page 332 (1988)	
10. (1932)	Beech N27°W 9.9	Iron Pipe		C.I.M.		C.I.M.	
	Maple S25°E 16.5	PP	SW 40.86	11" Pine	NW 85.57	12" Pine	NW 85.47
ST		9" Pine	NW 85.23	PP	SW 41.38	10" Pine	NE 124.35
uel Marrs		PP	W 135.89	PP	E 59.27	PP	SW 41.55
		PP	E 59.35	12" Pine	NE 124.18	PP	E 59.32

B. Description of corner evidence found and/or method applied in restoring or reestablishing corner:  
Found: Cast Iron Mon. - accepted as a careful and faithful perpetuation of the position of the original corner.


Found Witnesses:

Nail & tag in S side PP	E	59.69
Pk Nail in S side PP	E	59.64
Nail & tag in W side PP	E	59.30
Nail in W side PP	E	59.28
Nail & tag in NE side PP	SW	40.83
Nail in NE side PP	SW	40.78
Pk Nail in N side PP	SW	41.55

**P.A. 345 OTTAWA COUNTY**  
**PEER APPROVED** 9/22/94  
*Gordy D. Fedoroff*

C. Description of monument for corner and accessories established to perpetuate locating the position of the corner:

C-4	Cast Iron Mon.		
O.C. Remon.	Nail & tag in N side PP	N90°E	59.72
O.C. Remon.	Nail & tag in S side PP	S60°W	41.82
O.C. Remon.	Nail & tag in S side RR tie fence post	N90°W	108.01
O.C. Remon.	Nail & tag in W side twin 4" Basswood	N20°E	106.79
On CL 88th Avenue, Power Lines to W			

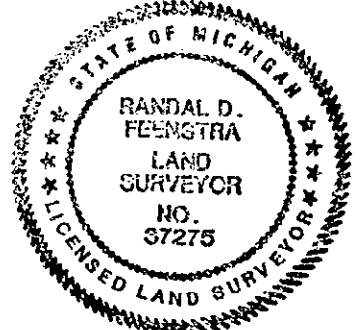

Signed by *Randal D. Feenstra* Date May 9, 1994  
Surveyor's Michigan License No. 37275