

SURVEY & REMONUMENTATION

OCT 24 1994

COMMISSION

OTTAWA COUNTY REMONUMENTATION

LAND CORNER RECORDATION CERTIFICATE
Filing Requirement of Act 74, Mich. P.A. 1970

RECORDED

OCT -7 PM 12:33

For corners in

Ottawa
(County)

Located In:

Corner Code #

1. Public Land Survey	T	6N	R	14W	C-5, SW 1/4 COR
	T		R		Sec. 8, Blendon
	T		R		
	T		R		
2. Property Controlling in Section	S		T		
	S		T		
3. Miscellaneous Property in Sec.	S		T		
	S		T		

Robert D. Feenstra
REGISTER OF DEEDS
OTTAWA COUNTY, MI

Register of Deeds Stamp & File Number


- 4. Lot No. _____, Recorded Plat _____
- 5. Private Claims _____

I, Randal D. Feenstra, in a field survey on May 9, 1994, do hereby certify that under requirements of P.A. 74, Michigan P.A. of 1970, the corner points mentioned in lines 1 and 2 above were in conformance with regulations and rules therefore as required in the current manual of survey instructions of the United States Department of the Interior, Bureau of Land Management or by a decree of a Court of Law and/or that the corner points mentioned in lines 3, 4 and 5 above were in conformance with the rules of the Michigan Board of Land Surveyors or by a Decree of a Court of Law; established, re-established, monumented, re-monumented, recovered, found as expressed below:

NOTE: Not more than 4 corners, all in the same town and range, may be recorded on this certificate.

A. Description of original monument and accessories and/or subsequent restoration:

L.O. (1932)	L-2, Pg. 585 (9/1974)	L-2, Pg. 713 (11/1974)	L-4, Pg. 132 (1980)
Maple N75°W 12.5	Found Angle Iron	PP N45°E 48.19	Set Cast Iron Monument
Maple S55°E 15.8	PP NW 49.31	St sign N50°E 31.25	Pole NE 47.68
ST	Support P NE 47.53	PP N45°W 50.16	PP NW 50.15
Muel Marrs	PP SE 72.78	PP S40°E 73.31	Cor fen. post SW 49.76
			PP SE 73.25

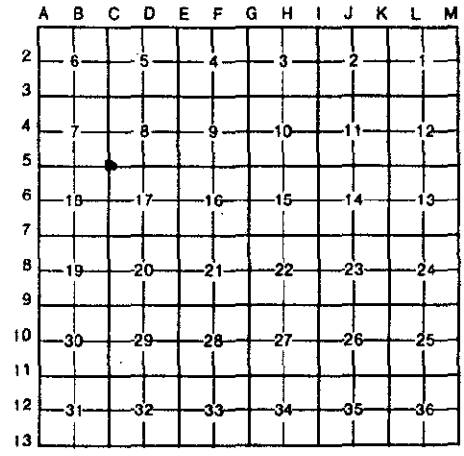

B. Description of corner evidence found and/or method applied in restoring or reestablishing corner:

Found: Cast Iron Mon. - accepted as a careful and faithful perpetuation of the position of the original corner.

Found Witnesses:

Nail & tag in W side PP	NE	47.81
Nail & tag in SW side PP	NE	47.24
Nail & tag in SW side PP	NE	47.25
Pk Nail in SW side PP	NE	47.21
Nail & tag in NE side PP	NW	50.56
Nail & tag in SE side PP	NW	49.68
Nail & tag in SW side PP	NW	50.38
Nail & tag in NW side PP	SE	72.82
Nail & tag in W side PP	SE	73.18

PA. 345 OTTAWA COUNTY
PEER APPROVED 8/22/94
Robert D. Feenstra

C. Description of monument for corner and accessories established to perpetuate locating the position of the corner:

C-5 Cast Iron Mon.		
O.C. Remon. Nail & tag in SE side PP	N45°E	47.73
O.C. Remon. Nail & tag in SW side PP	N45°W	50.34
O.C. Remon. Nail & tag in N side fence post	S45°W	53.19
O.C. Remon. Nail & tag in NE side PP	S45°E	73.19



Signed by *Randal D. Feenstra* Date May 9, 1994
Surveyor's Michigan License No. 37275