

**OTTAWA COUNTY REMONUMENTATION**

**LAND CORNER RECORDATION CERTIFICATE**  
Filing Requirement of Act 74, Mich. P.A. 1970

For corners in  
Ottawa  
(County)

Located In: Blendon Twp. Corner Code # D-1, N 1/4 cor.  
6N 14W  
Sec. 5

T	R	_____	
T	R	_____	
T	R	_____	
T	R	_____	
S	T	R	_____
S	T	R	_____
S	T	R	_____
S	T	R	_____

**RECORDED**

96 DEC 17 AM 10:14

*Randy D. Feenstra*  
REGISTER OF DEEDS  
OTTAWA COUNTY, MI

Register of Deeds Stamp & File Number

1. Public Land Survey

2. Property Controlling in Section

3. Miscellaneous Property in Sec.

4. Lot No. \_\_\_\_\_, Recorded Plat \_\_\_\_\_

5. Private Claims \_\_\_\_\_

I, Randal D. Feenstra, in a field survey on Feb. 20, 1996 do hereby state that under requirements of P.A. 74, Michigan P.A. of 1970, the corner points mentioned in lines 1 and 2 above were in conformance with regulations and rules therefore as required in the current manual of survey instructions of the United States Department of the Interior, Bureau of Land Management or by a decree of a Court of Law and /or that the corner points mentioned in lines 3, 4 and 5 above were in conformance with the rules of the Michigan Board of Land Surveyors or by a Decree of a Court of Law; established, re-established, monumented, recovered, found as expressed below:

NOTE: Not more than 2 corners, all in the same town and range, may be recorded on this certificate.

A	B	C	D	E	F	G	H	I	J	K	L	M
1												
2	6		5		4		3		2		1	
3												
4	7		8		9		10		11		12	
5												
6	18		17		16		15		14		13	
7												
8	19		20		21		22		23		24	
9												
10	30		29		28		27		26		25	
11												
12	31		32		33		34		35		36	
13												

A. Description of original monument and accessories and/or subsequent restoration:

G.L.O.	L-4, P-133, (1980)	L-5, P-153 (1984)	L-6, P-149 (1991)
Not Set	Cast Iron Monument	Cast Iron Monument	Cast Iron Monument
	P. Pole ENE 69.95°	P. Pole ENE 69.98°	6" Post NW 42.24'
	T. Pole NW 42.10°	P. Pole NNW 96.32°	P. Pole NW 96.32'
	St. Sign SE 22.76°	F. Post S 14.37°	1/2" rebar NNE 100.2°
	F. Post S 14.18°	N line Sec. 5 N 2.68°	1/2" rebar NE 124.10°
	Allendale Cor. E 22.50°	Allendale cor. E 22.50°	P. Pole NE 69.92°
			4" Post S 24.55°
			Allendale Cor. E 22.50°

B. Description of corner evidence found and/or method applied in restoring or reestablishing corner:

D-1 Found: Cast Iron Monument in Box

Nail SE side P. Pole Az. 65° 69.84'  
S 1/4 Sec. 32, T7N, R14W Az. 83° 22.49'  
1/2" Rebar W edge gravel road Az. 3° 100.18'


Determined to be closing corner. Townline is 2.97 feet North of this corner.

This position not established by original government surveyors. This monument is accepted as the best available evidence of the position of the corner.

P.A. 345 OTTAWA COUNTY  
PEER APPROVED 11-11-96  
*[Signature]*

C. Description of monument for corner and accessories established to perpetuate locating the position of the corner:

D-1 Set Ottawa County Monument (3/4" x 24" pin with cap on Townline	(SEE SKETCH ON BACK)
Ottawa County Remon. Nail & Tag in SE side P. Pole	AZ 67° 68.60'
Ottawa County Remon Nail & Tag in E side F. Post	AZ 316° 39.96'
Ottawa County Remon Nail and Tag in W 28" Elm	AZ 180° 187.14'
1/2" Rebar W edge gravel road	AZ 3° 97.21'
D-13 T7N, R14 W (Cast Iron Monument in box)	AZ 90° 22.30'
Closing Corner 2.97' South	

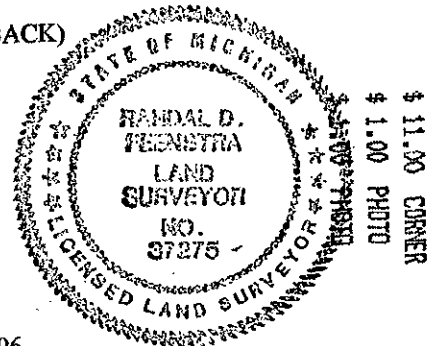

Signed by Randal D. Feenstra  
Surveyor's Michigan License No. 37275

Date February 20, 1996

