

OCT 24 1994

COMMISSION

**OTTAWA COUNTY REMONUMENTATION
LAND CORNER RECORDATION CERTIFICATE
Filing Requirement of Act 74, Mich. P.A. 1970**

RECORDED

94 OCT -7 PM 12:33


Dorothy A. Hollman
REGISTER OF DEEDS
OTTAWA COUNTY, MI

For corners in

Ottawa (County)	Located In:	Corner Code #
1. Public Land Survey	T <u>6N</u> R <u>14W</u>	E-3, NE 1/4 COR Sec. 8, Blendon
	T _____ R _____	_____
	T _____ R _____	_____
	T _____ R _____	_____
2. Property Controlling in Section	S _____ T _____ R _____	_____
	S _____ T _____ R _____	_____
3. Miscellaneous Property in Sec.	S _____ T _____ R _____	_____
	S _____ T _____ R _____	_____

Register of Deeds Stamp & File Number

4. Lot No. _____, Recorded Plat _____
5. Private Claims _____

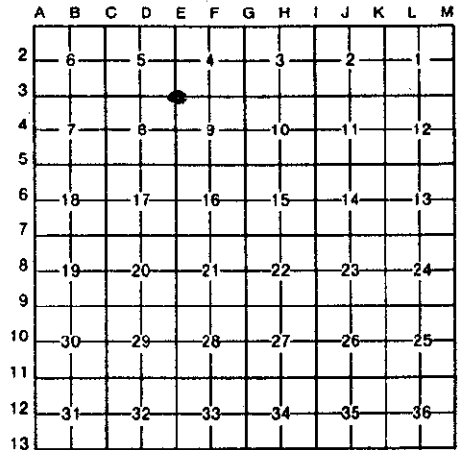

I, Randal D. Feenstra in a field survey on May 9, 1994, do hereby certify that under requirements of P.A. 74, Michigan P.A. of 1970, the corner points mentioned in lines 1 and 2 above were in conformance with regulations and rules therefore as required in the current manual of survey instructions of the United States Department of the Interior, Bureau of Land Management or by a decree of a Court of Law and/or that the corner points mentioned in lines 3, 4 and 5 above were in conformance with the rules of the Michigan Board of Land Surveyors or by a Decree of a Court of Law; established, re-established, monumented, re-monumented, recovered, found as expressed below:

NOTE: Not more than 4 corners, all in the same town and range, may be recorded on this certificate.

A. Description of original monument and accessories and/or subsequent restoration:

L.O. (1932)	Liber 2, Pg. 585 (1974)	Liber 5, Pg. 1 (1982)	Liber 5, Pg. 332 (1988)
Beech S75°E 12.5	3/4" PIPE	C.I.M.	C.I.M.
Birch S65°W 4.6	25" maple	NW 115.52	Nail & tag in PP SW 44.94
ST	PP	NW 40.02	CL St. Sign SE 45.50
uel Marrs	PP	SW 44.39	Nail in 36" Maple NW 116.05
	TP	SE 44.98	CL St. sign SE 45.35

B. Description of corner evidence found and/or method applied in restoring or reestablishing corner:

Found: Cast Iron Mon. in Mon. Box - accepted as a careful and faithful perpetuation of the position of the original corner.

Found Witnesses:


Nail in S side PP	N60°E 98.47
CL Street sign	S45°E 46.66

P.A. 345 OTTAWA COUNTY

PEER APPROVED 8/22/94
Gordy D. Hedewell

C. Description of monument for corner and accessories established to perpetuate locating the position of the corner:

E-3 Cast Iron Monument	
O.C. Remon. Nail & tag E side PP	N50°W 38.26
O.C. Remon. Nail & tag E side PP	S40°W 60.26
O.C. Remon. Nail & tag NW side PP	N60°E 98.43
O.C. Remon. Nail & tag NW side MBT support post	S45°E 45.46
CL Taylor Road ± 4' West of 80th CL	

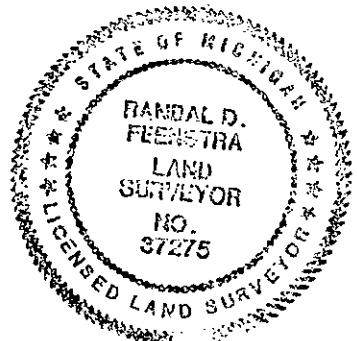

Signed by *Randal D. Feenstra*

Date May 9, 1994

Surveyor's Michigan License No. 37275