

SURVEY & REMONUMENTATION

JUN 28 1999

OTTAWA COUNTY REMONUMENTATION

RECORDED
98 NOV -4 PM 2: 32

LAND CORNER RECORDATION CERTIFICATE
Filing Requirement of Act 74, Mich. P.A. 1970

Randy Vugteveen
REGISTER OF DEEDS
OTTAWA COUNTY, MI

SECTION

For corners in

OTTAWA
(County)

Located In:

Corner Code #

- | | | |
|------------------------------------|--|--------------------------|
| 1. Public Land Survey | T <u>6N</u> R <u>14W</u> | <u>E-4 W 1/4 Cor Sec</u> |
| | T <u> </u> R <u> </u> | <u>9 Blendon Twp</u> |
| | T <u> </u> R <u> </u> | <u> </u> |
| | T <u> </u> R <u> </u> | <u> </u> |
| 2. Property Controlling in Section | S <u> </u> T <u> </u> R <u> </u> | <u> </u> |
| | S <u> </u> T <u> </u> R <u> </u> | <u> </u> |
| 3. Miscellaneous Property in Sec. | S <u> </u> T <u> </u> R <u> </u> | <u> </u> |
| | S <u> </u> T <u> </u> R <u> </u> | <u> </u> |

Register of Deeds Stamp & File Number

4. Lot No. _____, Recorded Plat _____
5. Private Claims _____

I, Randal J. Vugteveen, in a field survey on October 13, 1998, do hereby state that under requirements of P.A. 74, Michigan P.A. of 1970, the corner points mentioned in lines 1 and 2 above were in conformance with regulations and rules therefore as required in the current manual of survey instructions of the United States Department of the Interior, Bureau of Land Management or by a decree of a Court of Law and /or that the corner points mentioned in lines 3, 4 and 5 above were in conformance with the rules of the Michigan Board of Land Surveyors or by a Decree of a Court of Law, established, re-established, monumented, recovered, found as expressed below:

NOTE: Not more than 2 corners, all in the same town and range, may be recorded on this certificate.

	A	B	C	D	E	F	G	H	I	J	K	L	M
1													
2	6		5		4		3		2		1		
3													
4	7		8		9		10		11		12		
5													
6	18		17		16		15		14		13		
7													
8	19		20		21		22		23		24		
9													
10	30		29		28		27		26		25		
11													
12	31		32		33		34		35		36		
13													

A. Description of original monument and accessories and/or subsequent restoration:

E-4 GLO April 1832

Calvin Britain D.S.

Set Post

20" Elm S48°E 15 Links

Black Ash N18°W 14 Links

E-4 Liber 2 Page 287

Roon 1973

Set Cast Iron Mon.

18" Basswood ENE 36.28'

6" Ash WNW 31.59'

Power Pole NNW 70.95'

E-4 Liber 4, Page 170

Joiner 1981

Found Iron-Set Cast Iron Monument

18" Basswood NE 36.73'

11" Maple East 58.22'

12" Cherry West 33.93'

11" Tree NW 31.52'

(Continued on Back)

B. Description of corner evidence found and/or method applied in restoring or reestablishing corner:

E-4 Found 3/4" pipe and Cast Iron Monument

Holding Cast Iron Monument on East edge of gravel road

RLS # 18435 Capped Iron Az 270° 33.08'

Remains of Down N & S fence at W 1/8th line NW

1/4 Sec 9 East 1310'+/-

Consumers Power 1/2 Miles and angles fit the position of the Cast Iron Monument which also fit old O.C. Surveyors Notes 2657' to the Center of Sec 8.

Accepted Cast Iron Monument as a careful and faithful perpetuation of the position of the original corner.

C. Description of monument for corner and accessories established to perpetuate locating the position of the corner:

E-4 Cast Iron Monument on East side of Gravel Road

Set Ottawa County Remon Tag and Nail N Side P Pole S84°E 19.51'

Set Ottawa County Remon Tag and Nail E side P Pole N13°W 160.76'

Set Ottawa County Remon Tag and Nail S side 18" W Cherry Ave N87°W 53.15'


Set Ottawa County Remon Tag and Nail E side P Pole S29°W 73.81'

Fnd 3/4" Round Iron Pipe Az 270° 19.62'

OTTAWA COUNTY

PROF. SURV.

10/19/98

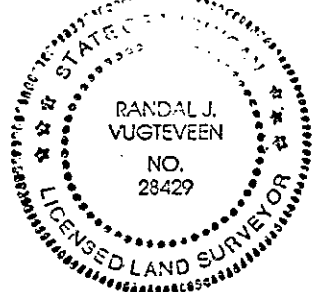

\$11.00 CORNER
Receipt #18213
\$2.00 PHOTO
Receipt #18213

Signed by *Randal J. Vugteveen*
Surveyor's Michigan License No. 28429

Date October 19, 1998

E-4 Blendon
 Liber 5 Page 332
 Rosema 1988
 Fd 1/2" Pipe
 Nail in S side 12" Maple E 58.60'
 Nail in S side TW 12' Cherry W 33.90'
 Nail and Tag in SW side 15" Tree NE 36.47'
 Nail in NE side 12" Ash NW 31.98'
 Found C.I. Mon E 19.53'

1961 Consumers Power Map
 Set 3/4" X 20" Pipe
 P Pole NNW 75.80'
 18" Ash NNE 36.26'
 18" Maple SE 27.90'
 T Pole SE 62.66'
 Kistler worksheet #7492 shows Iron Pipe set on
 straight line.

Liber 6 Page 342
 Baker 1997
 Cast Iron Monument
 Found 3/4" pipe N87°W 19.62' (Previously recorded at West 1/4 Corner)
 Found nail & tag E side P Pole S28°W 73.78'
 Found nail in N side Twin Cherry N85°W 53.38'
 Found nail & tag in S side Twin Cherry N87°W 53.12'
 Found nail & tag in NE side P Pole N13°W 160.75'
 Found nail in S side 20" Maple N85°E 38.80'
 Found nail in SW side 16" tree N25°E 24.23'

**SURVEY &
 REMONUMENTATION**
 JUN 28 1999
 SECTION

