

FEB 18 1994

COMMISSION

RECORDED

93 NOV -8 PM 1:58

OTTAWA COUNTY REMONUMENTATION
 LAND CORNER RECORDATION CERTIFICATE
 Filing Requirement of Act 74, Mich. P.A. 1970

Rhonda Caldwell
 REGISTER OF DEEDS
 OTTAWA COUNTY, MI

For corners in

<u>Ottawa</u> (County)	Located In:	Corner Code #
1. Public Land Survey	T <u>6N</u> R <u>14W</u>	<u>E-8, W$\frac{1}{2}$ COR.</u> <u>Sec. 21, Blendon</u>
	T ___ R ___	_____
	T ___ R ___	_____
	T ___ R ___	_____
2. Property Controlling in Section	S ___ T ___ R ___	_____
	S ___ T ___ R ___	_____
3. Miscellaneous Property in Sec.	S ___ T ___ R ___	_____
	S ___ T ___ R ___	_____
4. Lot No. _____, Recorded Plat _____		
5. Private Claims _____		

Register of Deeds Stamp & File Number

A	B	C	D	E	F	G	H	I	J	K	L	M
2	6	5	4	3	2	1						
3												
4	7	8	9	10	11	12						
5												
6	16	17	18	15	14	13						
7												
8	19	20	21	22	23	24						
9												
10	30	29	28	27	26	25						
11												
12	31	32	33	34	35	36						
13												

I, Randal D. Feenstra in a field survey on October 13, 19 93, do hereby certify that under requirements of P.A. 74, Michigan P.A. of 1970, the corner points mentioned in lines 1 and 2 above were in conformance with regulations and rules therefore as required in the current manual of survey instructions of the United States Department of the Interior, Bureau of Land Management or by a decree of a Court of Law and/or that the corner points mentioned in lines 3, 4 and 5 above were in conformance with the rules of the Michigan Board of Land Surveyors or by a Decree of a Court of Law; established, re-established, monumented, re-monumented, recovered, found as expressed below:

NOTE: Not more than 4 corners, all in the same town and range, may be recorded on this certificate.

A. Description of original monument and accessories and/or subsequent restoration:

E-8:	L.C.R.C.# L-5, P-337 (11-3-88)	L.C.R.C.# L-1, P-383 (4-20-72)
	C.I. Mon.	C.I. Mon.
	Nail in 24" Maple - NNW 75.22'	SE Cor. hse.#6819 - NW 131.71'
	Nail in P. Pole - NNE 74.40'	P. Pole - NW 91.91'
	Nail in MBT Pole - W 29.34'	20" Maple - NNW 74.10'
	Nail in 36" Maple - SSW 68.14	30" Maple - SSW 66.85'
		Trans. Pole - NE 71.02'


B. Description of corner evidence found and/or method applied in restoring or reestablishing corner:

E-8: Found Cast Iron Monument, accepted as a careful and faithful perpetuation of the position of the original corner.

Double headed Nail & Tag in NW side 38" Maple	S25°W	68.12'
Double headed Nail & Tag in E. side 26" Maple	N25°W	75.25'
SE Cor. Conc. Foundation to Hse. #6819	N45°W	131.71'

C. Description of monument for corner and accessories established to perpetuate locating the position of the corner:

E-8: Cast Iron Monument		
Set O.C. Remon. Nail & Tag in NW side 38" Maple	S25°W	68.10'
O.C. Remon. Nail & Tag in E. side 26" Maple	N25°W	75.22'
O.C. Remon. Nail & Tag in NW side P. Pole	N35°E	71.08'
O.C. Remon. Nail & Tag in E. side 28" Maple	N15°W	103.58'
6' W. of CL 80th		
Treeline to West and East		

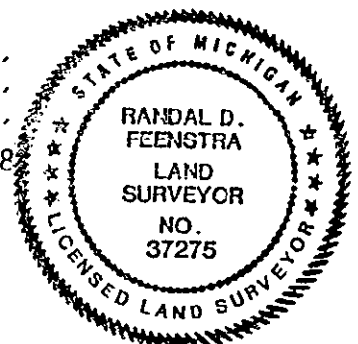

Signed by *Randal D. Feenstra* Date 10-18-93
 Surveyor's Michigan License No. 37275