SURVEY & REMONUMENTATION

FEB 18 1994

COMMISSION

RECORDED

93 NOV -8 PM 1:58

REGISTER OF DEEDS
OTTAWA COUNTY, MI

OTTAWA COUNTY REMONUMENTATION
LAND CORNER RECORDATION CERTIFICATE
Filing Requirement of Act 74, Mich. P.A. 1970

For corners in Ottawa (County)

	Located In:	Corner Code #
1. Public Land Survey	T 6N R 14W	E-9, SW COR.
	T ___ R ___	Sec. 21, Blendon
	T ___ R ___	
	T ___ R ___	
2. Property Controlling	S ___ T ___ R ___	
in Section	S ___ T ___ R ___	
3. Miscellaneous	S ___ T ___ R ___	
Property in Sec.	S ___ T ___ R ___	

Register of Deeds Stamp & File Number

4. Lot No. _____ , Recorded Plat _____
5. Private Claims _____

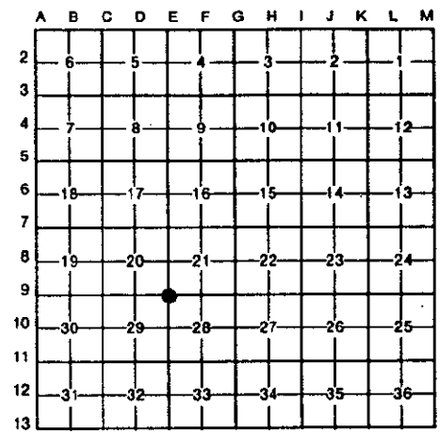

I, Randal D. Feenstra, in a field survey on October 13, 19 93, do hereby certify that under requirements of P.A. 74, Michigan P.A. of 1970, the corner points mentioned in lines 1 and 2 above were in conformance with regulations and rules therefore as required in the current manual of survey instructions of the United States Department of the Interior, Bureau of Land Management or by a decree of a Court of Law and/or that the corner points mentioned in lines 3, 4 and 5 above were in conformance with the rules of the Michigan Board of Land Surveyors or by a Decree of a Court of Law; established, re-established, monumented, re-monumented, recovered, found as expressed below:

NOTE: Not more than 4 corners, all in the same town and range, may be recorded on this certificate.

A. Description of original monument and accessories and/or subsequent restoration:

E-9:
L.C.R.C.# 1-5, P-122 (6-26-84)
C.I. Monument
T.P. NW 49.50'
Gas Pipeline sign NE 41.77'
P.P. SE 70.64'
CL stop sign SSE 44.20'

L.C.R.C.# 1-1, L-177 (11-29-71)
C.I. Monument

B. Description of corner evidence found and/or method applied in restoring or reestablishing corner:

E-9; Found Cast Iron Monument in box, accepted as a careful and faithful perpetuation of the position of the original corner.
PK and Tag in West side P.P. S60°E 72.24'

C. Description of monument for corner and accessories established to perpetuate locating the position of the corner:

E-9: Cast Iron Monument in Box

O.C. Remon. Nail & Tag in E. side fence post	S45°W	44.43'
O.C. Remon. Nail & Tag in N side fence post	S45°E	53.65'
O.C. Remon. Nail & Tag in W. side P.Pole	S60°E	72.26'
O.C. Remon. Nail & Tag in SE side 10" Oak	S65°W	114.53'

STATE OF MICHIGAN
RANDAL D. FEENSTRA
LAND SURVEYOR
NO. 37275
LICENSED LAND SURVEYOR

Signed by Randal D. Feenstra Date 10-18-93

Surveyor's Michigan License No. 37275

FORM APPROVED BY MICHIGAN STATE BOARD OF LAND SURVEYORS, JAN. 28, 1971
REVISED MAY 14, 1975
REVISED JAN., 1983