

SURVEY & REMONUMENTATION

FEB 27 1998

OTTAWA COUNTY REMONUMENTATION

LAND CORNER RECORDATION CERTIFICATE Filing Requirement of Act 74, Mich. P.A. 1970

SECTION

For corners in
Ottawa

	Located In:	Corner Code #
(County)	Blendon Twp. 6N 14W	F-1, N 1/4 cor.
1. Public Land Survey	T ___ R ___	Sec. 4
	T ___ R ___	
	T ___ R ___	
	T ___ R ___	
2. Property Controlling in Section	S ___ T ___ R ___	
	S ___ T ___ R ___	
3. Miscellaneous Property in Sec.	S ___ T ___ R ___	
	S ___ T ___ R ___	

RECORDED

97 DEC -8 AM 11:33

[Signature]
REGISTER OF DEEDS
OTTAWA COUNTY, MI

Register of Deeds Stamp & File Number

4. Lot No. _____, Recorded Plat _____
5. Private Claims _____

I, Randal D. Feenstra, in a field survey on Feb. 18, 1997 do hereby state that under requirements of P.A. 74, Michigan P.A. of 1970, the corner points mentioned in lines 1 and 2 above were in conformance with regulations and rules therefore as required in the current manual of survey instructions of the United States Department of the Interior, Bureau of Land Management or by a decree of a Court of Law and/or that the corner points mentioned in lines 3, 4 and 5 above were in conformance with the rules of the Michigan Board of Land Surveyors or by a Decree of a Court of Law, established, re-established, monumented, recovered, found as expressed below:

	A	B	C	D	E	F	G	H	I	J	K	L	M
1						●							
2	6	5			4		3		2		1		
3													
4	7	8			9		10		11		12		
5													
6	18	17			16		15		14		13		
7													
8	19	20			21		22		23		24		
9													
10	30	29			28		27		26		25		
11													
12	31	32			33		34		35		36		
13													

NOTE: Not more than 2 corners, all in the same town and range, may be recorded on this certificate.

A. Description of original monument and accessories and/or subsequent restoration:

G.L.O. Not Set LCRC, L-1, P. 557 F-1 Found Angle Iron P. Pole NW 70.29' T. Pole NE 84.54' T. Pole SE 67.60' T. Pole SW 39.77' Iron (Allendale Cor.) E 21.29'	LCRC, L-2, P. 543 F-1 Found Angle Iron Nail in NW Side T. Pole SW 39.98' Nail in SW Side T. Pole SE 67.97' Nail in NE Side P. Pole NW 70.71' Nail in SE Side T. Pole NE 84.91' Nail in SE Side 10" Buttment NE 111.53'	LCRC L-3, P. 367 F-1 Angle Iron T. Pole SE 67.99' T. Pole SW 35.45' P. Pole (side) NW 70.83' Allendale Cor. E 21.22'
		LCRC, L-4, P. 135 F-1 Set Cast Iron Monument T. Pedestal SW 35.03' P. Pole NW 70.44' Street Sign SE 64.17' T. Pedestal SE 67.93' Allendale Cor. E 21.20'

B. Description of corner evidence found and/or method applied in restoring or reestablishing corner:

F-1 Found: Cast Iron Monument in Mon. Box


Found: Nail and Bottle Cap SE Side P. Pole	NW 70.50'
Street Sign	SE 63.75'
CL Top Hydrant	NE 65.70'
Allendale Corner	E 21.15'

P.A. 345 OTTAWA COUNTY
PEER APPROVED 11-17-97
[Signature]

This position not established by original government surveyors. This monument is accepted as the best available evidence of the position of the corner.

C. Description of monument for corner and accessories established to perpetuate locating the position of the corner:

F-1 Cast Iron Monument in Mon. Box (on Townline to North)		
Ottawa County Remon Nail & Tag in S Side 18" Maple	N 65°E	111.67'
Ottawa County Remon Nail & Tag in Top Post by T. Pedestal	S 64°E	68.33'
Ottawa County Remon Nail & Tag in Top P. Pole Stump	S 33°W	46.90'
Ottawa County Remon Nail & Tag in E Side P. Pole	N 32°W	71.25'
Allendale Corner	East	21.15'
"X" Cut S End 21" Concrete Culvert	S 19°W	29.88'
CL E-W Bit. Rd. (Fillmore St.)	North	0.50'
CL Bit. Rd. to S (76th Ave.)	East	16.00'
CL Bit. Rd. to N (76th Ave.)	East	20.00'

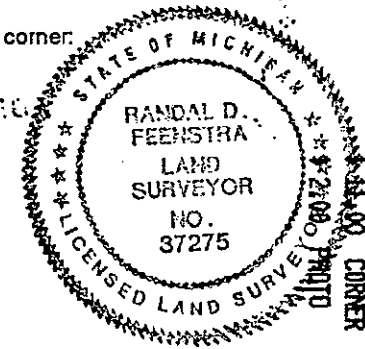

Signed by Randal D. Feenstra
Surveyor's Michigan License No. 37275

Date February 18, 1997

LCRC, L-6 P. 153

F-1 Replaced Cast Iron Monument 7/11/91 After Constr.

P.K. Top of 4' Post S 65°E 67.96'


CL Top of Hydrant N 75°E 65.71'

P.K. E Side P. Pole N 35°W 70.94'

"X" Cut S End Conc. Culvert S 20°W 29.84'

Sec. Corner East 21.16'

ALLENDALE TWP.

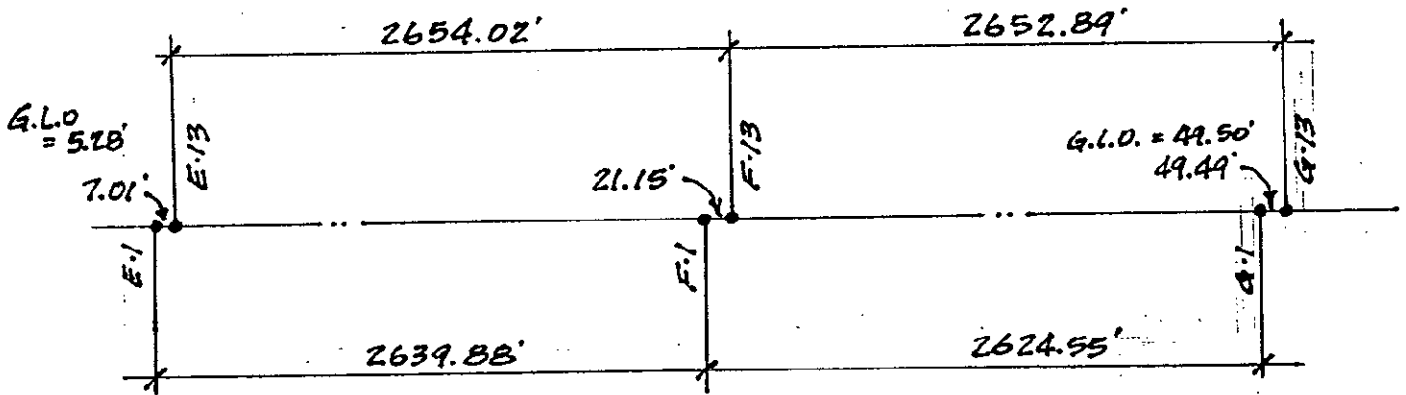

BLENDON TWP.

SURVEY &
REMONUMENTATION

FEB 27 1998

SECTION