

FEB 18 1994

COMMISSION

OTTAWA COUNTY REMONUMENTATION
LAND CORNER RECORDATION CERTIFICATE
Filing Requirement of Act 74, Mich. P.A. 1970

RECORDED

93 NOV -8 PM 1:58


Phyllis Holman
REGISTER OF DEEDS
OTTAWA COUNTY, MI

For corners in

Ottawa (County)	Located In:	Corner Code #
1. Public Land Survey	T 6N R 14W	F-7, N $\frac{1}{4}$ Cor. Sec. 21 Blendon
	T _____ R _____	_____
	T _____ R _____	_____
	T _____ R _____	_____
2. Property Controlling in Section	S _____ T _____ R _____	_____
	S _____ T _____ R _____	_____
3. Miscellaneous Property in Sec.	S _____ T _____ R _____	_____
	S _____ T _____ R _____	_____
4. Lot No. _____, Recorded Plat _____		
5. Private Claims _____		

Register of Deeds Stamp & File Number

I, Randal D. Feenstra in a field survey on October 13, 19 93, do hereby certify that under requirements of P.A. 74, Michigan P.A. of 1970, the corner points mentioned in lines 1 and 2 above were in conformance with regulations and rules therefore as required in the current manual of survey instructions of the United States Department of the Interior, Bureau of Land Management or by a decree of a Court of Law and/or that the corner points mentioned in lines 3, 4 and 5 above were in conformance with the rules of the Michigan Board of Land Surveyors or by a Decree of a Court of Law; established, re-established, monumented, re-monumented, recovered, found as expressed below:

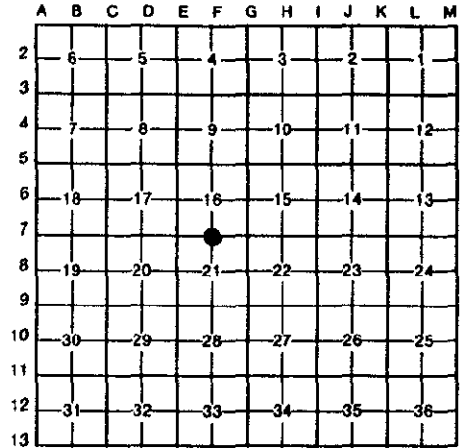

NOTE: Not more than 4 corners, all in the same town and range, may be recorded on this certificate.

A. Description of original monument and accessories and/or subsequent restoration:

F-7:		
L.C.R.C.# L-5, P-325 (8-4-88)		L.C.R.C.# L-5, P-192 (11-16-84)
1/2" Bar		1/2" Re-Rod
Guy Pole NNE 25.45'		Nail in P.P. SW 33.66'
1" Iron N 33.00'		Nail in 12" Pine NNE 68.48'
4" Poplar NW 48.2		Nail in conc. culv. ENE 123.54'
P. Pole WSW 73.26'		(W. end)
		Fence line & Brush Row to South-W. 36'±

B. Description of corner evidence found and/or method applied in restoring or reestablishing corner:


F-7: Found - 1/2" Re-Rod, accepted as a careful and faithful perpetuation of the position of the original corner.

Nail in S. side 12" Pine	N10°E	68.51'
PK in E. side P.P.	S40°W	33.66'
PK in W. end 12" conc. culvert	N70°E	123.54'

C. Description of monument for corner and accessories established to perpetuate locating the position of the corner:

F-7:

Set: Ottawa County Rod and Cap		
O.C. Remon. Nail & Tag in E. side 12" Pine	N10°E	68.44'
O.C. Remon. Nail & tag in E. side P.P.	S40°W	33.60'
"X" in E. side 12" conc. culv.	N70°E	149.86'
"X" in W. side 12" conc. culv.	N30°W	32.13'
@ CL Tyler & 30' ± E. of brushline to S.		

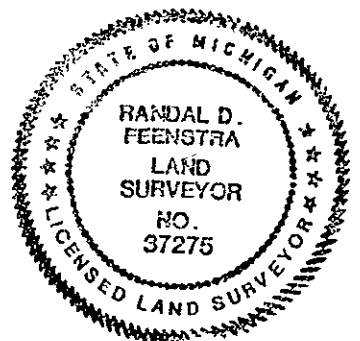

Signed by Randal D. Feenstra

Date 10-18-93

Surveyor's Michigan License No. 37275