

FEB 24 2000

OTTAWA COUNTY REMONUMENTATION
LAND CORNER RECORDATION CERTIFICATE
Filing Requirement of Act 74, Mich. P.A. 1970

RECORDED

99 SEP 23 PM 3: 20

For corners in SECTION

OTTAWA

(County)

Located In: Corner Code #
BLENDON TOWNSHIP

- 1. Public Land Survey T 6N R 14W F-13
T R S 1/4 Corner
T R Section 33
T R
- 2. Property Controlling S T R
in Section S T R
- 3. Miscellaneous S T R
Property In Sec. S T R


Sam Sibley
REGISTER OF DEEDS
OTTAWA COUNTY, MI

Register of Deeds Stamp & File Number

- 4. Lot No. _____, Recorded Plat _____
- 5. Private Claims _____

I, Rodney D. Unema, in a field survey on September 16, 19 99 do hereby state that under requirements of P.A. 74, Michigan P.A. of 1970, the corner points mentioned in lines 1 and 2 above were in conformance with regulations and rules therefore as required in the current manual of survey instructions of the United States Department of the Interior, Bureau of Land Management or by a decree of a Court of Law and for that the corner points mentioned in lines 3, 4 and 5 above were in conformance with the rules of the Michigan Board of Land Surveyors or by a Decree of a Court of Law; established, re-established, monumented, recovered, found as expressed below:

NOTE: Not more than 2 corners, all in the same town and range, may be recorded on this certificate.

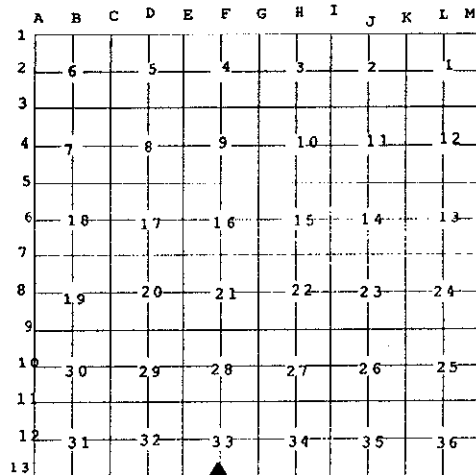

A. Description of original monument and accessories and/or subsequent restoration:

F-13 S 1/4 Corner, Section 33

Nov. 1831, G.L.O. Survey by
Sylvester Sibley
Set H.W.P.
12" Beech N36°E 8 links
10" Beech N44°W 41 links

Feb. 5, 1981 (Nederveld)
Liber 4, page 150
Found 3/4" Iron Pipe (per Witnesses)
Nail in tag on S sde 28" Oak WSW 122.01'
Nail in tag on NW sde CP Pole SW 115.90'
Nail in tag on SE sde CP Pole NE 69.55'
Iron West 46.77'

Jan. 5, 1982 (Joiner)
Liber 4, page 284
Set Cast Iron Monument
Zeeland corner W 46.72'
40" Oak WSW 121.99'
P. Pole SW 115.75'
Street sign S 19.80'
P. Pole NE 69.55'

B. Description of corner evidence found and/or method applied in restoring or reestablishing corner:

F-13 Found Cast Iron Monument in E-W Gravel Road (+/-6" down)

Found F-1, T5N, R14W West 46.72'
Centerline street sign S13°E 19.84'
Found nail & bottlecap in SE sde of P. Pole N46°E 69.54'
Found nail & tag in NW sde P. Pole S56°W 115.63'
Centerline of 40" Oak (no visible nails) S80°W 121.8'

Accepted as a careful and faithful perpetuation of the position of the original corner.

C. Description of monument for corner and accessories established to perpetuate locating the position of the corner:

F-13 Cast Iron Monument in Gravel Road (New Holland Street) +/-6" down
Centerline of Gravel Road to North (76th Ave.) East 2.5'
Set nail & O.C. remon tag in S. sde 40" Oak S80°W 122.11'
Set nail & O.C. remon tag in NW sde P. Pole S56°W 115.60'
Set nail & O.C. remon tag in SE sde P. Pole N46°E 69.53'
Set rero 0.5' East of base of street sign S13°E 19.86'
Centerline of E-W gravel road (New Holland) North 2'
F-1 T5N, R14W, cast iron mon. West 46.72'

9/20/99
RDU



Receipt #58324

Signed by Rodney D. Unema
Surveyor's Michigan License No. 33987

Date September 17, 1999