

SURVEY & REMONUMENTATION

OCT 24 1994

**OTTAWA COUNTY REMONUMENTATION
LAND CORNER RECORDATION CERTIFICATE
Filing Requirement of Act 74, Mich. P.A. 1970**

RECORDED

94 OCT -7 PM 12:33

For corners in **COMMISSION**

R. J. ...
**REGISTER OF DEEDS
OTTAWA COUNTY, MI**

| Ottawa (County) | Located In: | Corner Code # |
|---------------------------------------|--------------------------|----------------------------------|
| 1. Public Land Survey | T <u>6N</u> R <u>14W</u> | G-4, E 1/4 COR Sec. 9 Blendon |
| | T _____ R _____ | _____ |
| | T _____ R _____ | _____ |
| | T _____ R _____ | _____ |
| 2. Property Controlling in Section | S _____ T _____ R _____ | _____ |
| | S _____ T _____ R _____ | _____ |
| 3. Miscellaneous Property in Sec. | S _____ T _____ R _____ | _____ |
| | S _____ T _____ R _____ | _____ |
| 4. Lot No. _____, Recorded Plat _____ | | |
| 5. Private Claims _____ | | |

Register of Deeds Stamp & File Number

| | A | B | C | D | E | F | G | H | I | J | K | L | M |
|----|----|----|----|----|----|----|---|---|---|---|---|---|---|
| 2 | 6 | 5 | 4 | 3 | 2 | 1 | | | | | | | |
| 3 | | | | | | | | | | | | | |
| 4 | 7 | 8 | 9 | 10 | 11 | 12 | | | | | | | |
| 5 | | | | | | | | | | | | | |
| 6 | 18 | 17 | 16 | 15 | 14 | 13 | | | | | | | |
| 7 | | | | | | | | | | | | | |
| 8 | 19 | 20 | 21 | 22 | 23 | 24 | | | | | | | |
| 9 | | | | | | | | | | | | | |
| 10 | 30 | 29 | 28 | 27 | 26 | 25 | | | | | | | |
| 11 | | | | | | | | | | | | | |
| 12 | 31 | 32 | 33 | 34 | 35 | 36 | | | | | | | |
| 13 | | | | | | | | | | | | | |

I, Randal D. Feenstra in a field survey on May 9, 1994, do hereby certify that under requirements of P.A. 74, Michigan P.A. of 1970, the corner points mentioned in lines 1 and 2 above were in conformance with regulations and rules therefore as required in the current manual of survey instructions of the United States Department of the Interior, Bureau of Land Management or by a decree of a Court of Law and/or that the corner points mentioned in lines 3, 4 and 5 above were in conformance with the rules of the Michigan Board of Land Surveyors or by a Decree of a Court of Law; established, re-established, monumented, re-monumented, recovered, found as expressed below:

NOTE: Not more than 4 corners, all in the same town and range, may be recorded on this certificate.

A. Description of original monument and accessories and/or subsequent restoration:

| | | |
|---------------------|------------------------|---|
| L.L.O. (1932) | L-2, Pg. 239 (7/1973) | L-2, Page 287 (8/1973) |
| OST | 1/2" Iron | |
| Tamerack S69°W 4.6 | CL St. sign | NW 24.53 Found STL. Rod in Monument Box |
| Tamerack S72°E 29.7 | Nail in side T pole | SE 101.00 Street sign NW 24.56 |
| amuel Marrs | CL of Culvert at N end | NE 66.7 Telephone Pole WNW 38.60 |

-5 Page 169 (1984)

et C.I.M. Street S. WNW 24.90' N. End Metal Culv. NE 66.75'
ower Pole W 20.37' Power Pole SE 101.00'

B. Description of corner evidence found and/or method applied in restoring or reestablishing corner:

ound: Cast Iron Mon. in Mon. Box - accepted as a careful and faithful perpetuation of the position of the original corner.

ound Witnesses:


| | | |
|----------------------------|-------|--------|
| CL of Culvert at North end | N55°E | 66.72 |
| Pk nail NE side PP | S40°E | 101.00 |
| MBT support post | N65°E | 87.00 |
| MBT support post | S60°W | 38.98 |

**P.A. 345 OTTAWA COUNTY
PEER APPROVED** 8/22/94

Randy P. Redwell

C. Description of monument for corner and accessories established to perpetuate locating the position of the corner:

| | | |
|--|-------|--------|
| L-4 Cast Iron Mon. | | |
| L.C. Remon. Nail & tag W side PP | S40°E | 100.77 |
| L.C. Remon. Nail & tag S side Light Pole | E | 20.39 |
| L.C. Remon. Nail & tag W side MBT support post | N65°E | 87.00 |
| L.C. Remon. Nail & tag N side MBT support post | S60°W | 38.98 |
| CL of 72nd and CL of Bauer Road | | |

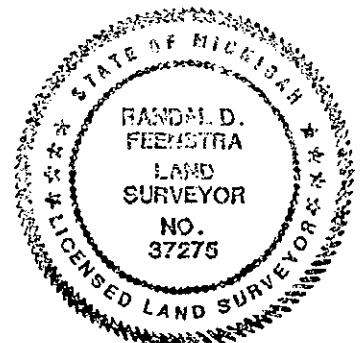

Signed by Randal D. Feenstra

Date May 9, 1994

Surveyor's Michigan License No. 37275