

SURVEY & REMONUMENTATION

FEB 18 1994

COMMISSION

OTTAWA COUNTY REMONUMENTATION
 LAND CORNER RECORDATION CERTIFICATE
 Filing Requirement of Act 74, Mich. P.A. 1970

RECORDED

93 NOV -8 PM 1:58

Royce A. Holloman
 REGISTER OF DEEDS
 OTTAWA COUNTY, MI

For corners in

Ottawa
 (County)

Located In:

Corner Code #

1. Public Land Survey	T	<u>6N</u>	R	<u>14W</u>	<u>G-7, NE COR</u>
	T		R		<u>Sec.21, Blendon</u>
	T		R		
	T		R		
2. Property Controlling in Section	S		T	R	
	S		T	R	
3. Miscellaneous Property in Sec.	S		T	R	
	S		T	R	

Register of Deeds Stamp & File Number

4. Lot No. _____, Recorded Plat _____
 5. Private Claims _____

	A	B	C	D	E	F	G	H	I	J	K	L	M
2	6	5	4	3	2	1							
3													
4	7	8	9	10	11	12							
5													
6	18	17	16	15	14	13							
7													
8	19	20	21	22	23	24							
9													
10	30	29	28	27	26	25							
11													
12	31	32	33	34	35	36							
13													

I, Randal D. Feenstra in a field survey on October 13, 19 93
do hereby certify that under requirements of P.A. 74, Michigan P.A. of 1970, the corner points mentioned in lines 1 and 2 above were in conformance with regulations and rules therefore as required in the current manual of survey instructions of the United States Department of the Interior, Bureau of Land Management or by a decree of a Court of Law and/or that the corner points mentioned in lines 3, 4 and 5 above were in conformance with the rules of the Michigan Board of Land Surveyors or by a Decree of a Court of Law; established, re-established, monumented, re-monumented, recovered, found as expressed below:

NOTE: Not more than 4 corners, all in the same town and range, may be recorded on this certificate.

A. Description of original monument and accessories and/or subsequent restoration:

G-7:	L.C.R.C.# 1-2, P-469 (5-11-74)	L.C.R.C.# L-5, P-123 (6-26-84)	L.C.R.C.# L-5, P-204 (4-20-85)
	3/4" Pipe	Cast Iron Monument	Cast Iron Monument
	P.Pole SW 45.60'	T. Pole SW 50.33'	T. Pole SW 50.32'
	Fence post SE 37.03'	21" Maple SSW 79.48'	18" Maple SSW 79.51'
	P.Pole NE 39.35'	14" Maple SSE 124.67'	12" Maple SSE 124.73'
		P.Pole NW 39.30'	P. Pole NE 39.33'


B. Description of corner evidence found and/or method applied in restoring or reestablishing corner:

G-7: Found Cast Iron Monument in Box, accepted as a careful and faithful perpetuation of the position of the original corner.
 Nail & Tag in N. side 21" Maple S45°W 110.30'
 PK in E. side P.P. S40°E 51.44'
 PK in NW side P.P. N45°E 39.17'
 Nail in W. side 14" Maple S20°E 124.68'

C. Description of monument for corner and accessories established to perpetuate locating the position of the corner:

G-7: Cast Iron Monument in Box
 O.C. Remon. Nail & Tag in N. side 21" Maple S45°W 110.25'
 O.C. Remon. Nail & Tag in E. side 14" Maple S55°W 98.89'
 O.C. Remon. Nail & Tag in E. side P.P. S40°E 51.41'
 O.C. Remon. Nail & Tag in NW side P.P. N45°E 39.18'

3' S. & 1.5' E. of CL "X" 72nd Ave. & Tyler Street

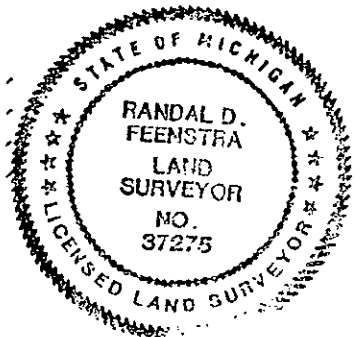

Signed by *Randal D. Feenstra* Date 10-18-93
 Surveyor's Michigan License No. 37275