

**SURVEY &
REMONUMENTATION**

APR 05 1996
COMMISSION

**OTTAWA COUNTY REMONUMENTATION
LAND CORNER RECORDATION CERTIFICATE
Filing Requirement of Act 74, Mich. P.A. 1970**

For corners in
Ottawa

(County)

Located In:

Corner Code #

1. Public Land Survey	Blendon Twp.		G-11, NWcor. Sec. 34
	T <u>6N</u>	R <u>14W</u>	
	T _____	R _____	
	T _____	R _____	
2. Property Controlling in Section	S _____	T _____	R _____
	S _____	T _____	R _____
3. Miscellaneous Property in Sec.	S _____	T _____	R _____
	S _____	T _____	R _____


RECORDED

95 NOV 29 PM 1:44

Ralph D. Redwood
REGISTER OF DEEDS
OTTAWA COUNTY, MI

Register of Deeds Stamp & File Number

4. Lot No. _____, Recorded Plat _____
5. Private Claims _____

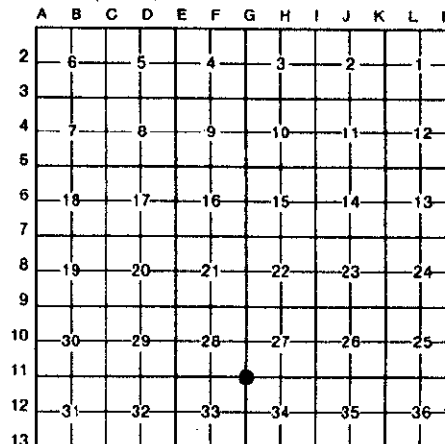

Randal D. Feenstra November 6 95

I, _____, in a field survey on _____, 19_____, do hereby certify that under requirements of P.A. 74, Michigan P.A. of 1970, the corner points mentioned in lines 1 and 2 above were in conformance with regulations and rules therefore as required in the current manual of survey instructions of the United States Department of the Interior, Bureau of Land Management or by a decree of a Court of Law and/or that the corner points mentioned in lines 3, 4 and 5 above were in conformance with the rules of the Michigan Board of Land Surveyors or by a Decree of a Court of Law; established, re-established, monumented, re-monumented, recovered, found as expressed below:

NOTE: Not more than 4 corners, all in the same town and range, may be recorded on this certificate.

A. Description of original monument and accessories and/or subsequent restoration:

G.L.O. (1832) Calvin Britain 20" Beech N33°E 10 lks. 3" Beech S10°W 13 lks.	LIBER 1, PAGE 177 (1971) Iron Pipe CL N end 18" culv. NE 28.50' CL S end 18" culv. SE 34.00' St. Sign W 33.35'	LIBER 2, PAGE 687 (1974) Mon. box St. Sign W 33.35' "X" in 18" culv. ESE 46.64' "X" in 18" culv. ENE 43.47'	LIBER 5, PAGE 119 (1984) C.I.M. 3" Tree W 47.57' P. Pole SW 81.82' Fence Post SE 58.26' Fence Post NE 54.47'
--	--	---	---

B. Description of corner evidence found and/or method applied in restoring or reestablishing corner:

Found: C.I.M. in box	Accepted as a careful and faithful perpetuation of the position of the original corner.
Nail in S side Fence Post	NE 54.56'
Nail in N side P. Pole	SW 81.74'

P.A. 345 OTTAWA COUNTY
PEER APPROVED 11/20/95

Randal D. Feenstra
D D V

C. Description of monument for corner and accessories established to perpetuate locating the position of the corner:

G-11 C.I.M. in Box		
Ottawa County Remon. Nail & Tag in S. side F. post	73°	54.59'
Ottawa County Remon. Nail & Tag in N side P. Pole	247°	81.75'
Ottawa County Remon. Nail & Tag in S side 7" Elm	275°	47.52'
Ottawa County Remon. Nail & Tag in W side F. Post	30°	66.88'

On centerline Van Buren and 72nd Ave.



Signed by Randal D. Feenstra
Surveyor's Michigan License No. 37275

Date November 6, 1995