

SURVEY & REMONUMENTATION

OCT 24 1994

OTTAWA COUNTY REMONUMENTATION

RECORDED

COMMISSION

LAND CORNER RECORDATION CERTIFICATE
Filing Requirement of Act 74, Mich. P.A. 1970

94 OCT -7 PM 12:33

For corners in

Phyllis Robinson
REGISTER OF DEEDS
OTTAWA COUNTY, MI

Ottawa (County)	Located In:	Corner Code #
1. Public Land Survey	T 6N R 14W	H-7, N 1/4 COR Sec. 22, Blendon
	T R	
	T R	
	T R	
2. Property Controlling in Section	S T R	
	S T R	
3. Miscellaneous Property in Sec.	S T R	
	S T R	
4. Lot No. _____, Recorded Plat _____		
5. Private Claims _____		

Register of Deeds Stamp & File Number

	A	B	C	D	E	F	G	H	I	J	K	L	M
2	6	5	4	3	2	1							
3													
4	7	8	9	10	11	12							
5													
6	10	17	16	15	14	13							
7													
8	19	20	21	22	23	24							
9													
10	30	29	28	27	26	25							
11													
12	31	32	33	34	35	36							
13													

I, Randal D. Feenstra, in a field survey on May 4, 1994, do hereby certify that under requirements of P.A. 74, Michigan P.A. of 1970, the corner points mentioned in lines 1 and 2 above were in conformance with regulations and rules therefore as required in the current manual of survey instructions of the United States Department of the Interior, Bureau of Land Management or by a decree of a Court of Law and/or that the corner points mentioned in lines 3, 4 and 5 above were in conformance with the rules of the Michigan Board of Land Surveyors or by a Decree of a Court of Law; established, re-established, monumented, re-monumented, recovered, found as expressed below:

NOTE: Not more than 4 corners, all in the same town and range, may be recorded on this certificate.

A. Description of original monument and accessories and/or subsequent restoration:

L.O. (1832) POST	Liber 2, Page 705 (1974)	Liber 4, Page 268 (1981)
1" Maple N47°W 10.6	3/4" Iron	Cast Iron Mon.
2" Beach S62.5°E 14.5	Pk in P.Pole NW 76.62'	Power Pole NW 76.63
	Pk in service pole SW 100.69'	12" Pine S 25.13
Samuel Marrs	Nail in 10" Pine South 25.06'	8" Pine SE 33.17
		12" Pine ESE 56.69

Liber 5, Page 204 (1985)
Cast iron mon.; Nail W side 10" Pine S 25.09; Pk in NE side P.Pole NW 76.65; Nail in NE side 12" Pine SE 33.17; Nail SW side 8" Pine ESE 56.69

B. Description of corner evidence found and/or method applied in restoring or reestablishing corner:

Found: Cast Iron Monument - accepted as a careful and faithful perpetuation of the position of the original corner.

Found Witnesses:

Pk in N side PP	NW 75.45
Dbl-headed nail in W side 12" pine	S 25.06
Nail in NE side 8" Pine	SE 33.15
Nail in SW side 12" Pine	ESE 56.64

P.A. 345 OTTAWA COUNTY


PEER APPROVED

Gordon P. Hedewell

C. Description of monument for corner and accessories established to perpetuate locating the position of the corner:

H-7 - Cast iron monument	
O.C. Remon. Nail & Tag in S side PP	N60°W 75.69
O.C. Remon. Nail & Tag in E side 12" Pine	S10°E 24.99
O.C. Remon. Nail & Tag in W side 8" Pine	S35°E 32.83
O.C. Remon. Nail & Tag in N side 12" Pine	S60°E 56.81

On CL Tyler Street Tree line to N.

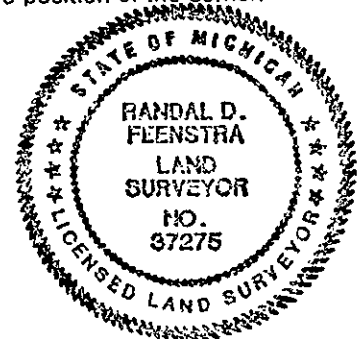

Signed by

Randal D. Feenstra

Date May 4, 1994

Surveyor's Michigan License No. 37275